



ALEDO ISD BOARD MEETING TEMPLATE

MEETING DATE: April 19, 2021

AGENDA ITEM: Consider Approval of Purchase of Fine Arts Equipment/Furniture for Aledo Middle School

PRESENTER: Earl Husfeld, Chief Financial Officer and Tyler Boswell, Director of Construction and Facilities

BACKGROUND INFORMATION:

- Per Board Policy CH (Local), any single, budgeted purchase of goods or services that costs \$50,000 or more, regardless of whether the goods or services are competitively purchased, shall require Board approval before a transaction may take place.
- As you are aware, renovations/additions to Aledo Middle School (AMS) were included within the District's 2019 Bond Program.
- As we shared with you during the March 22, 2021 board meeting, included within this project cost were funds allocated for the purchase of fine arts equipment/furniture for the new fine arts area of the AMS renovation.
- The quote from Wenger Corporation (Wenger) includes the plan and pricing to complete the work for both new and relocating Wenger cabinets. The quote includes the purchase of additional new units/casework, as well as two (2) mobilizations: one to remove the existing units/casework and relocate to the designated storage area at AMS and another mobilization to return and install both new and old units/casework in early August.
- Mr. Joey Paul and Mr. Joey Qualls have reviewed the Wenger quote to ensure nothing was omitted.
- To ensure the best pricing and value, the District utilized the TASB BuyBoard purchasing cooperative to obtain this quote from Wenger Corporation.

FISCAL INFORMATION:

The amount of \$98,204.62 will be paid with 2019 bond funds allotted for the Aledo Middle School project.

ATTACHMENTS:

Wenger Corporation Quote Number 3210260

ADMINISTRATIVE RECOMMENDATION:

The Administration recommends the Board of Trustees approve the quote submitted by Wenger Corporation in the amount of \$98,204.62 for the purchase and installation of fine arts equipment/furniture for Aledo Middle School as presented.

Wenger Corporation
555 Park Drive
Owatonna, MN 55060-4940
United States



Phone: 507-455-4100
Fax: 507-445-4258

Quote Number: 3210260

Proposal: New and Relocated Existing
Cabinets

C O R P O R A T I O N

QUOTE

Date: 04/12/2021
Page: 1 of 4
Cust #: 00172962

Quote To: Aledo Middle School 416 S FM 1187 Aledo TX 76008-4407 United States Phone: Fax: E-Mail:	Date: 4/12/2021 Expires: 5/12/2021 Reference: Sales Person: Christopher Flemming Created By: Deb Goette
------------------------------------------------------------------------------------------------------------------------------------------------------------	--------------------------------------------------------------------------------------------------------------------------------------------------------

Quote Comments:

Wenger is an approved vendor for Music Equipment for BuyBoard. Items on this quotation are available on BuyBoard Bid #619-20. This contract is in effect from 09/01/2020 to 08/31/2021.

Reference

- * Wenger Drawing 20P29663 Rev 2*
- * Wenger AcoustiCabinets Technical Sheet*
- * Price based on standard Wenger construction, sizes, and finishes.*

** Price includes two mobilizations: One to remove 28 existing AcoustiCabinets from installation and place them into storage on-site provided by others and one to deliver and install 34 new AcoustiCabinets plus relocation hardware/end panels to reinstall the 28 cabinets removed from installation in previous trip. Pricing through 2021.*

** Price is based on ground floor removal, storage and installation that does not require use of stairs or elevator. If use of stairs or elevator is required, additional charges will apply.*

CLARIFICATIONS

=====

** Field measurements are not included. Use of closure panels that are cut to size on site generally negates the requirement for field measurements by Wenger.*

PRODUCT INFORMATION

=====

- * DWG files of the referenced drawings above are requested to be provided at time of order.*
- * End cover panels and closure panels in the selected color combination are included in the price shown. ALL CHANGES TO APPROVED WENGER LAYOUT REQUESTED ON SITE OR AFTER INSTALLATION WILL INCUR ADDITIONAL CHARGES.*
- * Pricing is based on Wenger standard cabinet construction which includes oyster color for cabinet body and white polyethylene shelves. Cabinet face, edging, wood and grille doors, end panels, and closure panels can be chosen from available Wenger colors.*
- * Door number sets are not included. Templates are available on Wenger's website for customer to download and print labels.*
- * Wenger Storage Cabinets, Music Library Systems, and GearBoss Shelving have a 10-year warranty.*

TERMS AND CONDITIONS

=====

** Pricing is for delivery and installation through 2021.*

Wenger Corporation
 555 Park Drive
 Owatonna, MN 55060-4940
 United States



Phone: 507-455-4100
 Fax: 507-445-4258

C O R P O R A T I O N

QUOTE

Date: 04/12/2021
 Page: 2 of 4
 Cust #: 00172962

Quote Number: 3210260

Proposal: New and Relocated Existing
 Cabinets

** Price does not include Sales Tax. If this is for a tax exempt organization and this quote includes tax, please send a copy of the tax exempt certificate and Wenger will remove the sales tax. Thank you.*

** Price does not include Field Measurements.*

** Price includes TWO mobilizations: One for removal of 28 existing AcoustiCabinets from installation and placed into storage on-site provided by others. One for delivery of 34 new AcoustiCabinets plus relocation hardware/end panels for previously removed cabinets w/installation and demonstration of product at time of delivery. If customer authorizes delivery & jobsite is not ready to receive product and installation, customer shall be responsible for additional mobilization and other expenses.*

** Wenger shall attend jobsite meetings as necessary, while on site performing work.*

** If a payment bond is required by the Owner, the General Trades agree to provide a copy.*

** The time for delivery shown on the face of this quotation, if any, is an estimate only. Wenger Corporation will not be liable for any loss or damage to Buyer or others due to delay or not delivering in accordance with the estimated date regardless of cause. Wenger Corporation will select method of delivery unless specified by customer.*

** Full payments are due seven days after payment is received or should have been received by Contractor from Owner.*

Final payment is due 60 days after substantial completion of Wenger Corporation's work. Retainage held shall not exceed the amount withheld by Owner and/or allowable by law.

** Wenger Corporation shall not waive its right to file a lien or bond claim, nor its right to payment for work properly performed and accepted by owner or its representative.*

** Wenger Corporation accepts liability for bodily injury and property damage only to the extent of the direct costs caused by its own negligent acts during the performance of our work.*

** Wenger Corporation expressly conditions all orders upon the acceptance by Buyer of Company's terms and conditions without change unless specifically set forth in writing and accepted by the signature of an authorized representative of Company at Owatonna, MN.*

** Notwithstanding anything to the contrary in this agreement, Wenger shall not be liable for delay or non-performance caused by any of the following circumstances when beyond its control: acts of God, explosions, riots, labor disputes (provided Wenger has exercised reasonable commercial efforts to avoid it), failures of utilities or public services, civil unrest, foreign or domestic governmental regulation or order, public health emergencies, natural disasters, cyber-attacks, wars, acts of foreign enemies, sabotage or terrorism, including sub-supplier delays caused by any of the above provided the same are not caused or contributed to by the negligence or fault of Wenger ("Force Majeure").*

USD

Line	PartNum/Description	Qty
1.00	Freight Freight Services	1 EA
	<div style="border: 1px solid black; padding: 5px;"> <p><i>Accessorials Applied:</i></p> <p><i>LiftGate</i></p> </div>	
2.00	Install Installation Services	1 EA
	<div style="border: 1px solid black; padding: 5px;"> <p>----- <i>Installation Comments</i> -----</p> <p><i>1st trip-Remove 28 previously installed cabinets to be put in staorage,provided by others, on site</i></p> </div>	
3.00	Install Installation Services	1 EA
	<div style="border: 1px solid black; padding: 5px;"> <p>----- <i>Installation Comments</i> -----</p> <p><i>Demonstration at time of install.</i></p> <p><i>2nd trip-Reinstall 28 cabinets previously removed from storage. Includes installation of 34 new cabinets installed at the same time.</i></p> </div>	

Wenger Corporation
555 Park Drive
Owatonna, MN 55060-4940
United States



Phone: 507-455-4100
Fax: 507-445-4258

Quote Number: 3210260

C O R P O R A T I O N
QUOTE

Date: 04/12/2021
Page: 3 of 4
Cust #: 00172962

Proposal: New and Relocated Existing
Cabinets

25.00	CTO-CabinetClosureKit Closure Cabinet,CF	1	EA
Band Rehearsal 4.417			
4.00	255A002.102 AcoustiCabinet #02, Undefined Color, Composite Wood, compartment waterfall door, hinged left	5	EA
5.00	255A004.102 AcoustiCabinet #04, Undefined Color, Composite Wood, compartment waterfall door, hinged left	5	EA
6.00	255A005.101 AcoustiCabinet #05, Undefined Color, Composite Wood, compartment waterfall door, hinged left	7	EA
7.00	255A010.101 AcoustiCabinet #10, Undefined Color, Composite Wood, compartment waterfall door, hinged left	2	EA
8.00	255A011.101 AcoustiCabinet #11, Undefined Color, Composite Wood, compartment waterfall door, hinged left	3	EA
9.00	255A915.102 AcoustiCabinet #15, RTA, Undefined Color, Composite Wood, compartment waterfall door	10	EA
Ensemble #3 4.414			
10.00	255A010.101 AcoustiCabinet #10, Undefined Color, Composite Wood, compartment waterfall door, hinged left	1	EA
11.00	255A915.102 AcoustiCabinet #15, RTA, Undefined Color, Composite Wood, compartment waterfall door	1	EA
Instrument Storage 4.423			
12.00	M12 Cabinet Relocation Hardware	1	EA
13.00	X000045 SCREW,SM,PPHD.,ZP., #8 X 5/8	56	EA
14.00	145A288 BRACKET,CONNECTOR,CABINET	28	EA
15.00	250B350.10 FILLER STRIP,80.00",0355 OYS	28	EA
16.00	250A515.7 NUT,INSERT,1/4-20 UNC-2B,0255	28	EA

Wenger Corporation
555 Park Drive
Owatonna, MN 55060-4940
United States



Phone: 507-455-4100
Fax: 507-445-4258

Quote Number: 3210260

C O R P O R A T I O N

QUOTE

Date: 04/12/2021
Page: 4 of 4
Cust #: 00172962

Proposal: New and Relocated Existing
Cabinets

17.00	250A516.10 SCREW,MACH,1/4-20X1.77",0255	28	EA
18.00	RM11774 TAPE,FOAM,2 WAY, .18X.5X1.5	84	EA
19.00	250203307 End Cover Panel, 20" UltraStor (19.25") x 84" High, RH, Evening Tigris, Composite Wood	2	EA
20.00	250201689 End Cover Panel, 20" UltraStor (19.25") x 84" High, LH, Evening Tigris, Composite Wood	6	EA
21.00	250201069 End Cover Panel, 30" UltraStor (29.25") x 84" High, RH, Evening Tigris, Composite Wood	3	EA
22.00	250201068 End Cover Panel, 30" UltraStor (29.25") x 84" High, LH, Evening Tigris, Composite Wood	3	EA
23.00	250201071 End Cover Panel, 40" UltraStor (39.25") x 84" High, RH, Evening Tigris, Composite Wood	1	EA
24.00	250201070 End Cover Panel, 40" UltraStor (39.25") x 84" High, LH, Evening Tigris, Composite Wood	1	EA

Total Net Price: \$98,204.62
Total Taxes \$0.00

Quote Total \$98,204.62



MUSIC EDUCATION AND PERFORMING ARTS

Owatonna Office: Phone 800.4WENGER (493-6437) Worldwide +1.507.455.4100 | Parts & Service 800.887.7145 | wengercorp.com | 555 Park Drive, PO Box 448 | Owatonna | MN 55060-0448

Syracuse Office: Phone 800.836.1885 Worldwide +1.315.451.3440 | jrclancy.com | 7041 Interstate Island Road | Syracuse | NY 13209-9713

ATHLETICS Phone 800.493.6437 | email gearboss@wengercorp.com | gearboss.com | 555 Park Drive, PO Box 448 | Owatonna | MN 55060-0448

WENGER GENERAL NOTES FOR THIS PROJECT:

1. VERIFICATION OF BUILDING DIMENSIONS TO BE CONFIRMED BY GENERAL CONTRACTOR PRIOR TO CONSTRUCTION. PRODUCT IS PREFABRICATED IN STANDARD SIZES.
2. WALL/FLOOR AREA SPECIFIED FOR PRODUCT INSTALLATION MUST BE FREE OF OBSTRUCTIONS SUCH AS LIGHT SWITCHES, OUTLETS, HVAC, CLOCKS, SIGNS, ETC.
3. CLOSURE PANELS IN THE SELECTED COLOR COMBINATION ARE INCLUDED IN BID PRICE AND SHOWN AS PER DRAWING. ALL CHANGES TO APPROVED WENGER LAYOUT ON SITE OR AFTER INSTALLATION WILL INCUR ADDITIONAL CHARGES.
4. END COVER PANELS ARE INCLUDED IN BID PRICE AND SHOWN AS PER DRAWING. SEE INDIVIDUAL ROOM DRAWING FOR COLOR COMBINATION.
5. WENGER OFFERS STANDARD COLOR COMBINATIONS AS SHOWN ON CABINETS: COLOR SAMPLE CARD. NO OTHER OPTIONS AVAILABLE.

WENGER GENERAL CABINET NOTES:

1. IN AN AREA WHERE SOFFITS ARE TO BE CONSTRUCTED ABOVE WENGER CABINETS, A ROUGH OPENING HEIGHT OF 7'-6" IS REQUIRED FOR CABINET INSTALLATION.
2. CABINET DOORS HAVE LATCHES READY TO RECEIVE STANDARD PADLOCKS. PADLOCKS ARE NOT INCLUDED.


DWG NUMBER	INDEX OF DRAWINGS
20P29663-1	COVER SHEET - GENERAL NOTES
20P29663-2	BAND REHEARSAL 4.417 - PLAN & ELEVATION
20P29663-3	ENSEMBLE #3 4.414 - PLAN & ELEVATION
20P29663-4	INSTRUMENT STORAGE 4.423 - PLAN & ELEVATION

SIGNATURE REQUIRED

END COVER & CLOSURE PANELS IN THE SELECTED COLOR COMBINATION ARE INCLUDED IN BID PRICE AND SHOWN AS PER DRAWING. ALL CHANGES TO APPROVED WENGER LAYOUT ON SITE OR AFTER INSTALLATION WILL INCUR ADDITIONAL CHARGES.

SIGNATURE: _____

DATE: _____

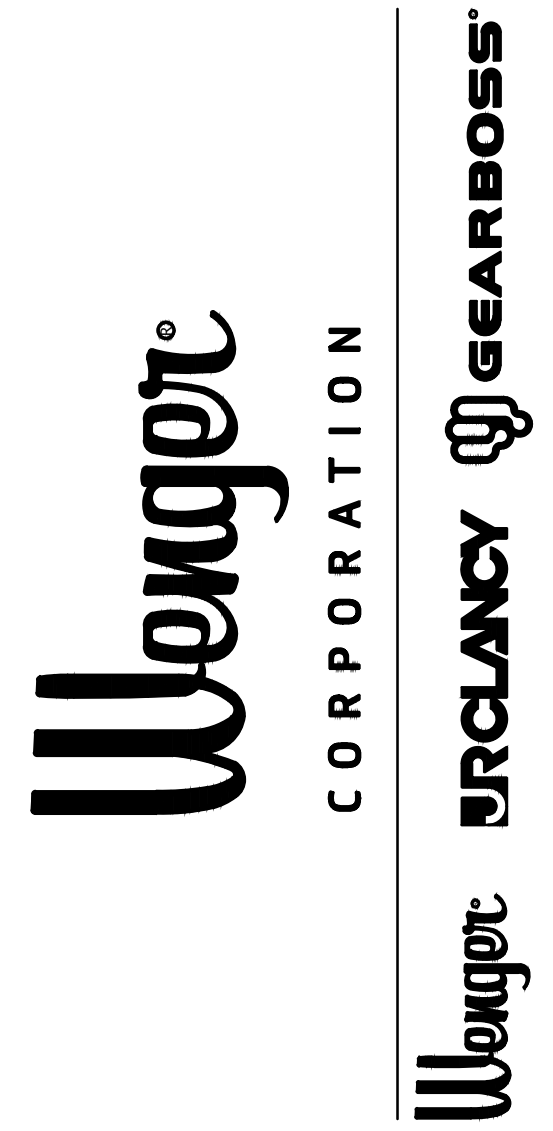

THIS DRAWING AND RELATED SPECIFICATIONS ARE CONFIDENTIAL AND PROPRIETARY TO THE WENGER CORPORATION. COPYRIGHT 2019 WENGER CORPORATION ALL RIGHTS RESERVED

REVIEWED AND APPROVED
 REVISE AND RESUBMIT
 REVIEWED AND APPROVED WITH COMMENTS

_____ DATE
 _____ SIGNATURE

Aledo Middle School


ALEDO
TX, 76008

ARCHITECT:

CONSULTANT:

CONTRACTOR:

FINISH: WEIGHT: GENERIC:

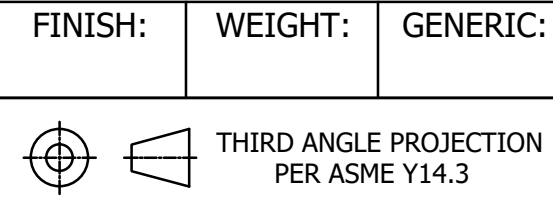

DRAWING TITLE:
COVER SHEET


PROJECT NUMBER:
20323131

SCALE: DO NOT SCALE DRAWING

DATE	DRN BY	CHK BY	APVD BY
07/28/20	VW	CZ	CZ

REV	DATE	DRN BY	REVISION DESCRIPTION
2	4/7/21	VW	REVISED CABINET LAYOUT IN ALL ROOMS PER NEW CABINET QUANTITIES.
1	7/28/20	VW	CREATED INITIAL DRAWING FOR REVIEW

DRAWING NUMBER: **20P29663-1** REV: **2**

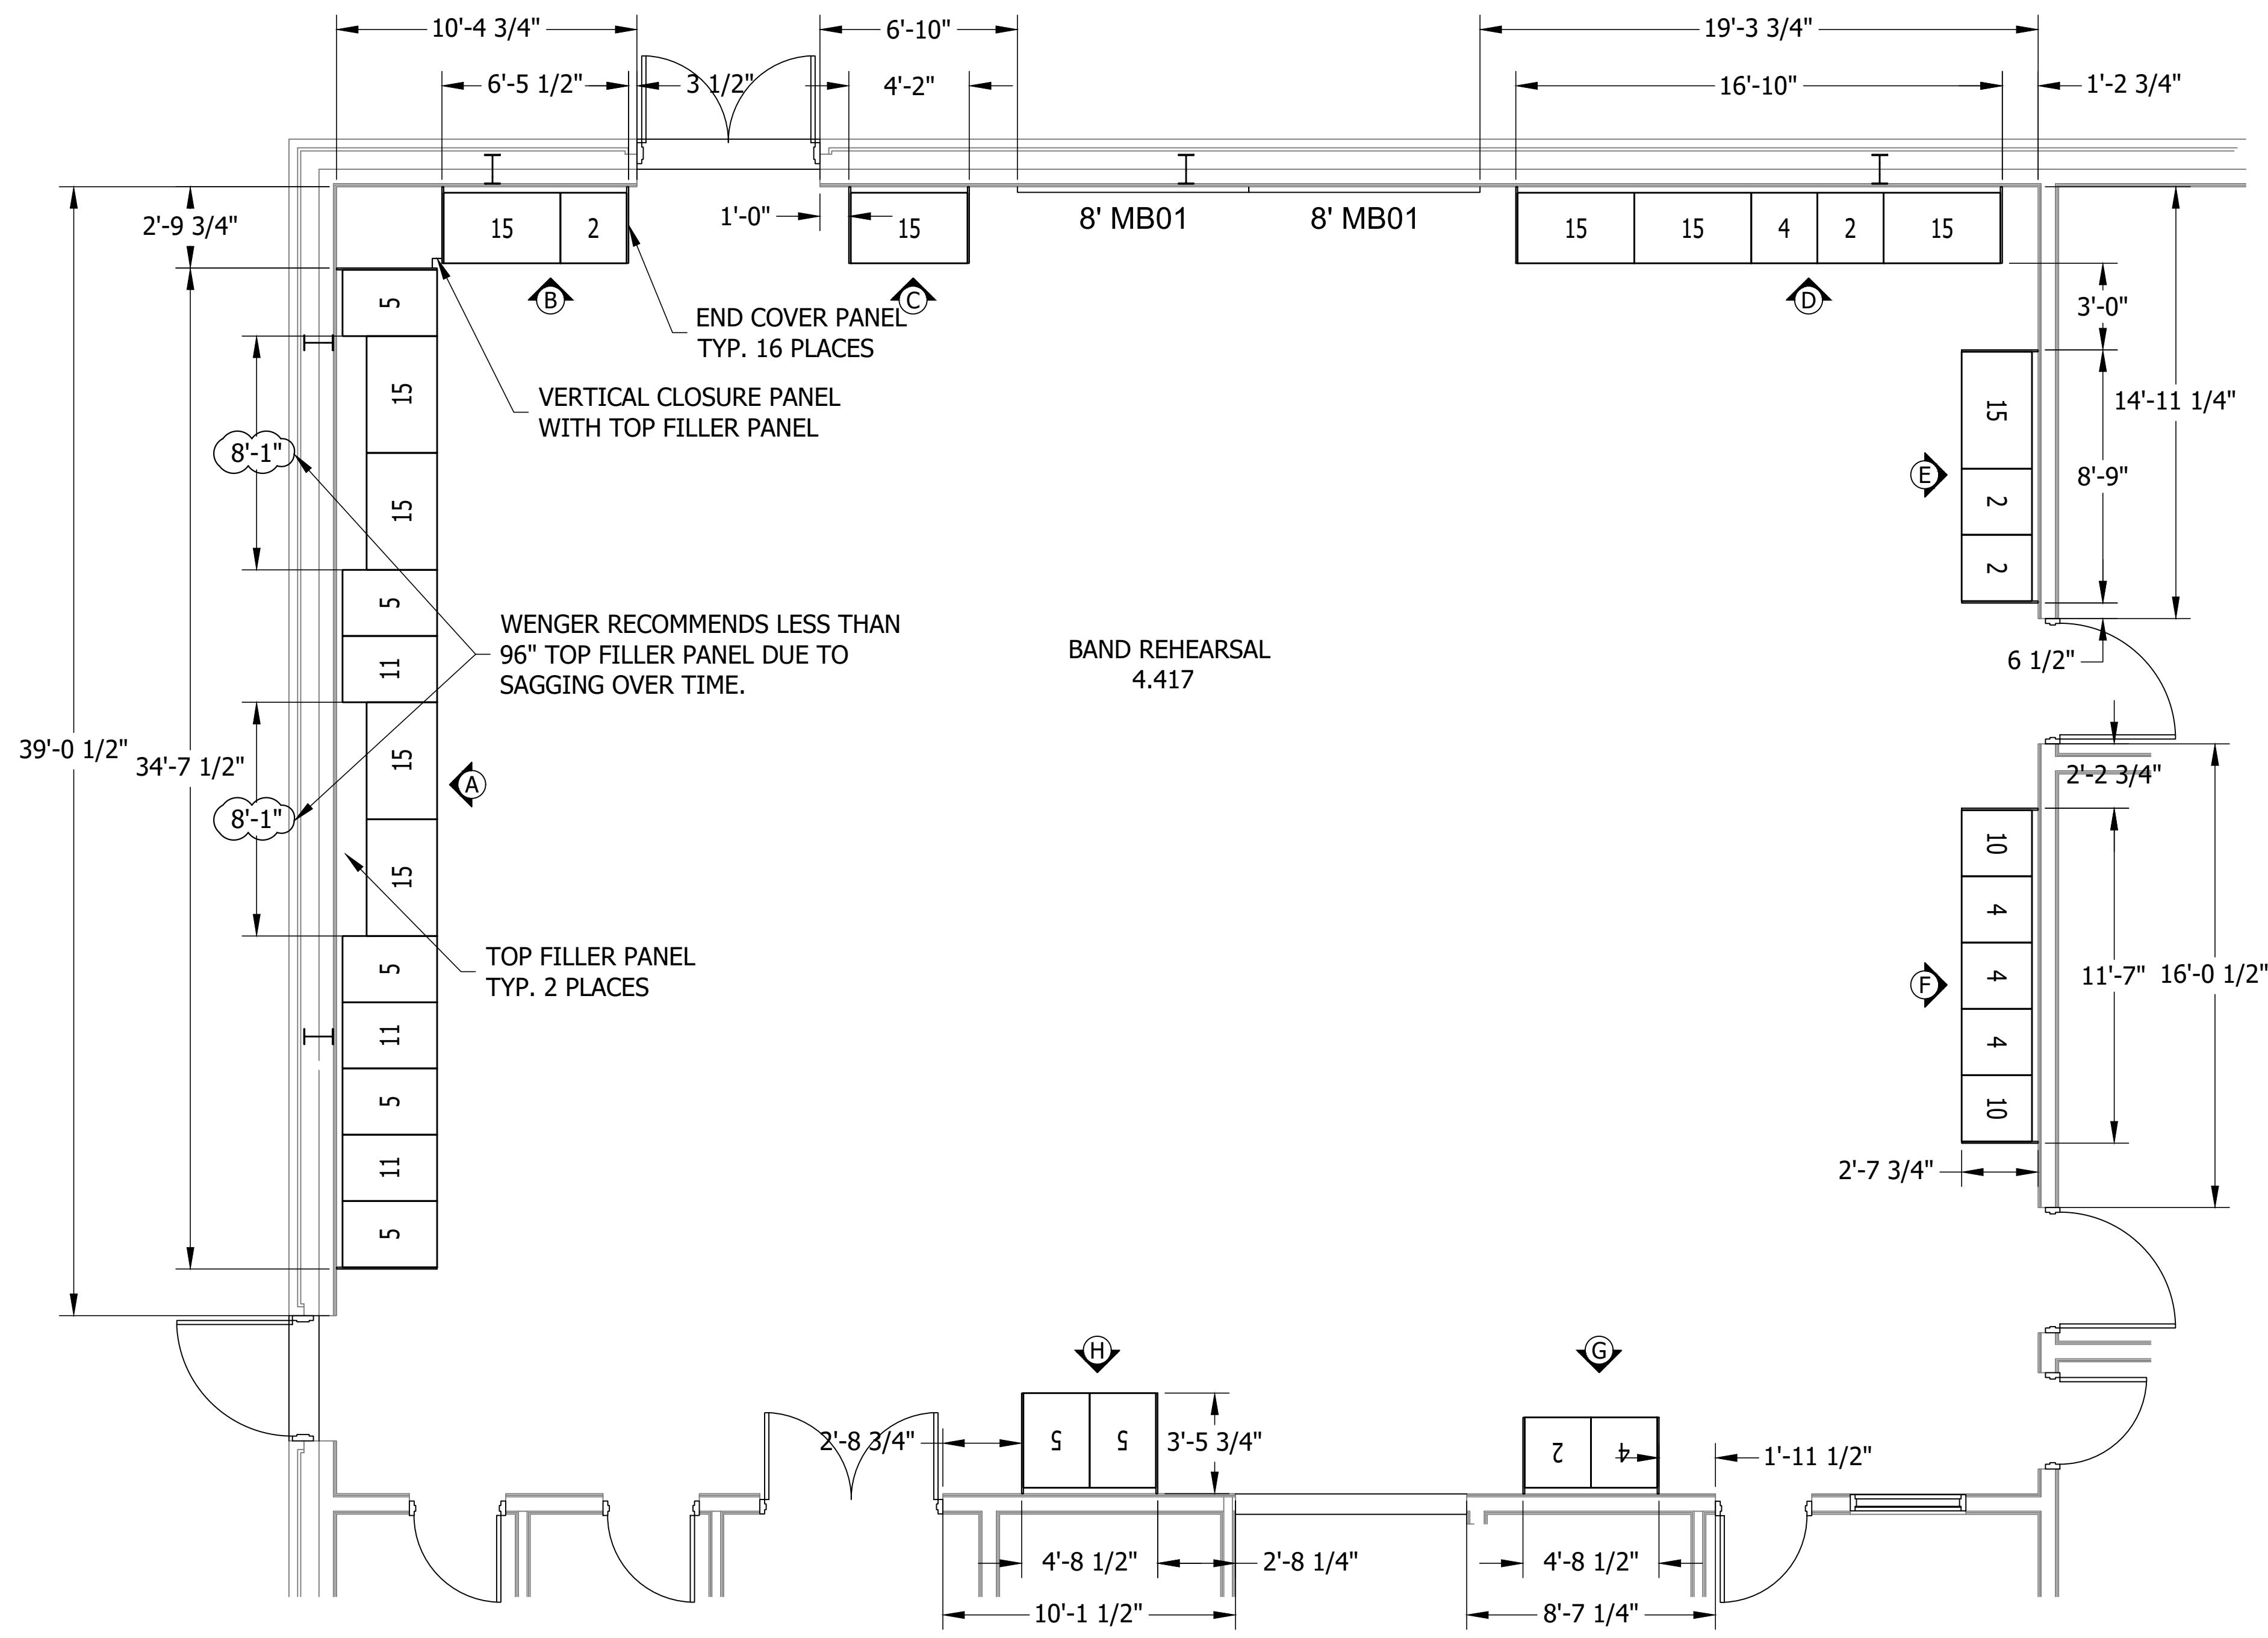

WENGER PRODUCTS	
QTY.	DESCRIPTION
5	#02 ACOUSTICABINET
5	#04 ACOUSTICABINET
7	#05 ACOUSTICABINET
2	#10 ACOUSTICABINET
3	#11 ACOUSTICABINET
10	#15 ACOUSTICABINET
32	TOTAL

THIS DRAWING AND RELATED SPECIFICATIONS ARE CONFIDENTIAL AND PROPRIETARY TO THE WENGER CORPORATION. COPYRIGHT 2019 WENGER CORPORATION ALL RIGHTS RESERVED

REVIEWED AND APPROVED
 REVISE AND RESUBMIT
 REVIEWED AND APPROVED WITH COMMENTS

SIGNATURE _____ DATE _____

Aledo Middle School

ALEDO TX, 76008

ARCHITECT: _____

CONSULTANT: _____

CONTRACTOR: _____

FINISH: _____ WEIGHT: _____ GENERIC: _____

THIRD ANGLE PROJECTION PER ASME Y14.3


DRAWING TITLE:
BAND REHEARSAL 4.417 -
ACOUSTICABINET LAYOUT

PROJECT NUMBER:
20323131


SCALE: DO NOT SCALE DRAWING

DATE	DRN BY	CHK BY	APVD BY
07/28/20	VW	CZ	CZ


DRAWING NUMBER: **20P29663-2** REV: **2**

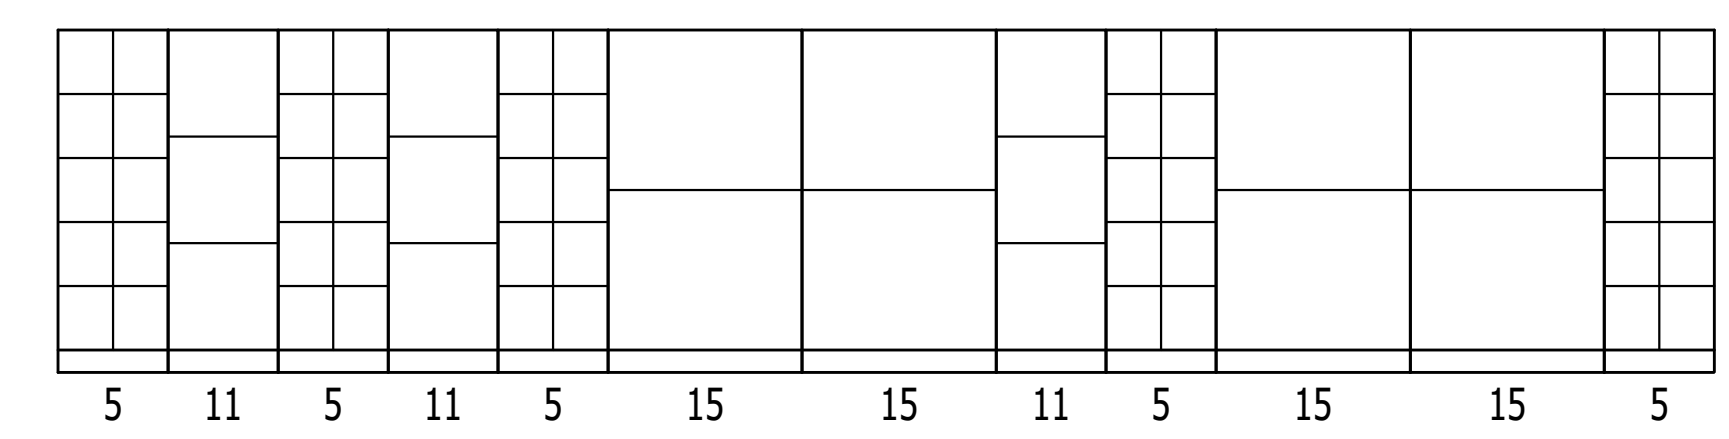


VIEW "A"

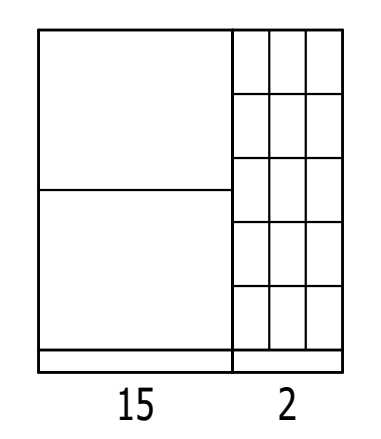


VIEW "B"

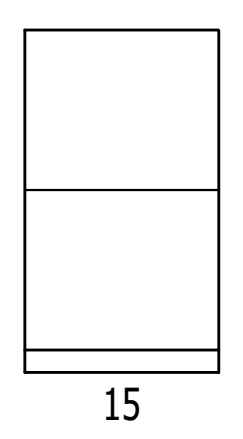


VIEW "C"

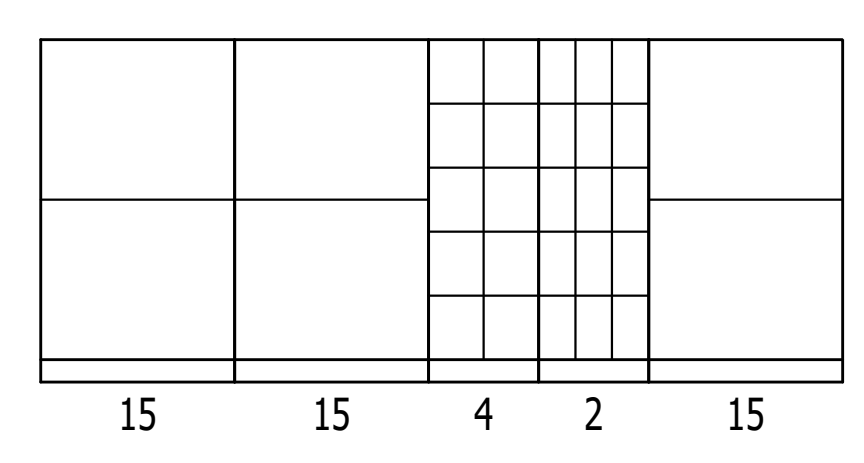


VIEW "D"

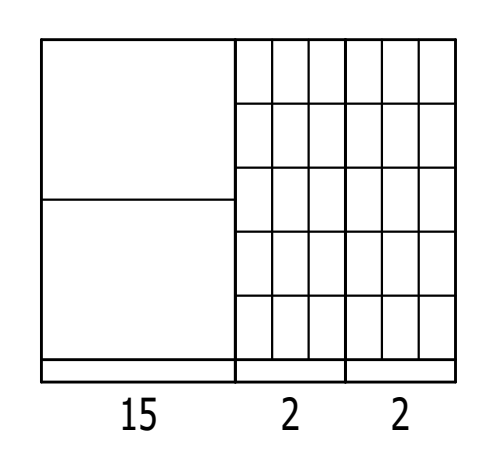


VIEW "E"

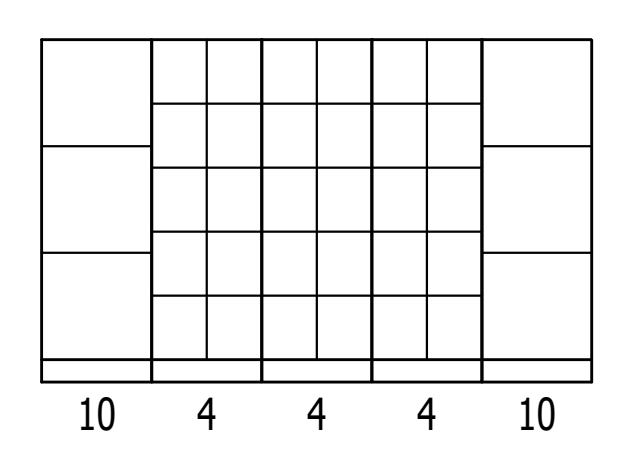

VIEW "F"

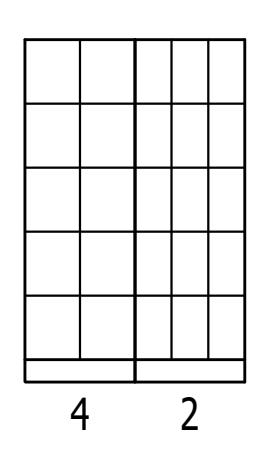

VIEW "G"

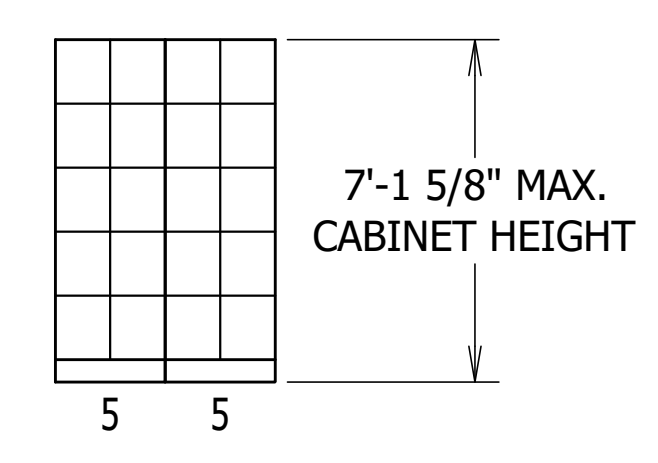



VIEW "H"

BOX A CABINETS TO HAVE WATERFALL COMPARTMENT GRILLE DOORS. COLOR TO MATCH HARDWARE AS INDICATED IN **BOX B**.


BOX B CABINET COLOR COMBINATION TO BE SELECTED FROM WENGER STANDARD COLOR COMBINATIONS. COLOR COMBINATION SELECTED _____

BOX C CABINETS TO BE CONSTRUCTED OF NO ADDED FORMALDEHYDE COMPOSITE WOOD.

WENGER PRODUCTS	
QTY.	DESCRIPTION
1	#10 ACOUSTICABINET
1	#15 ACOUSTICABINET
2	TOTAL

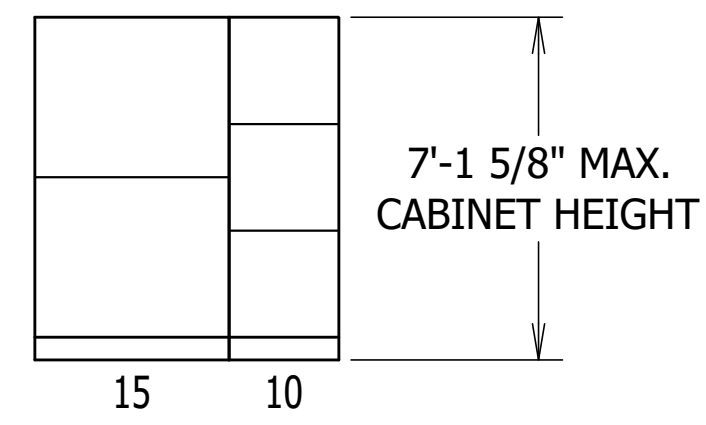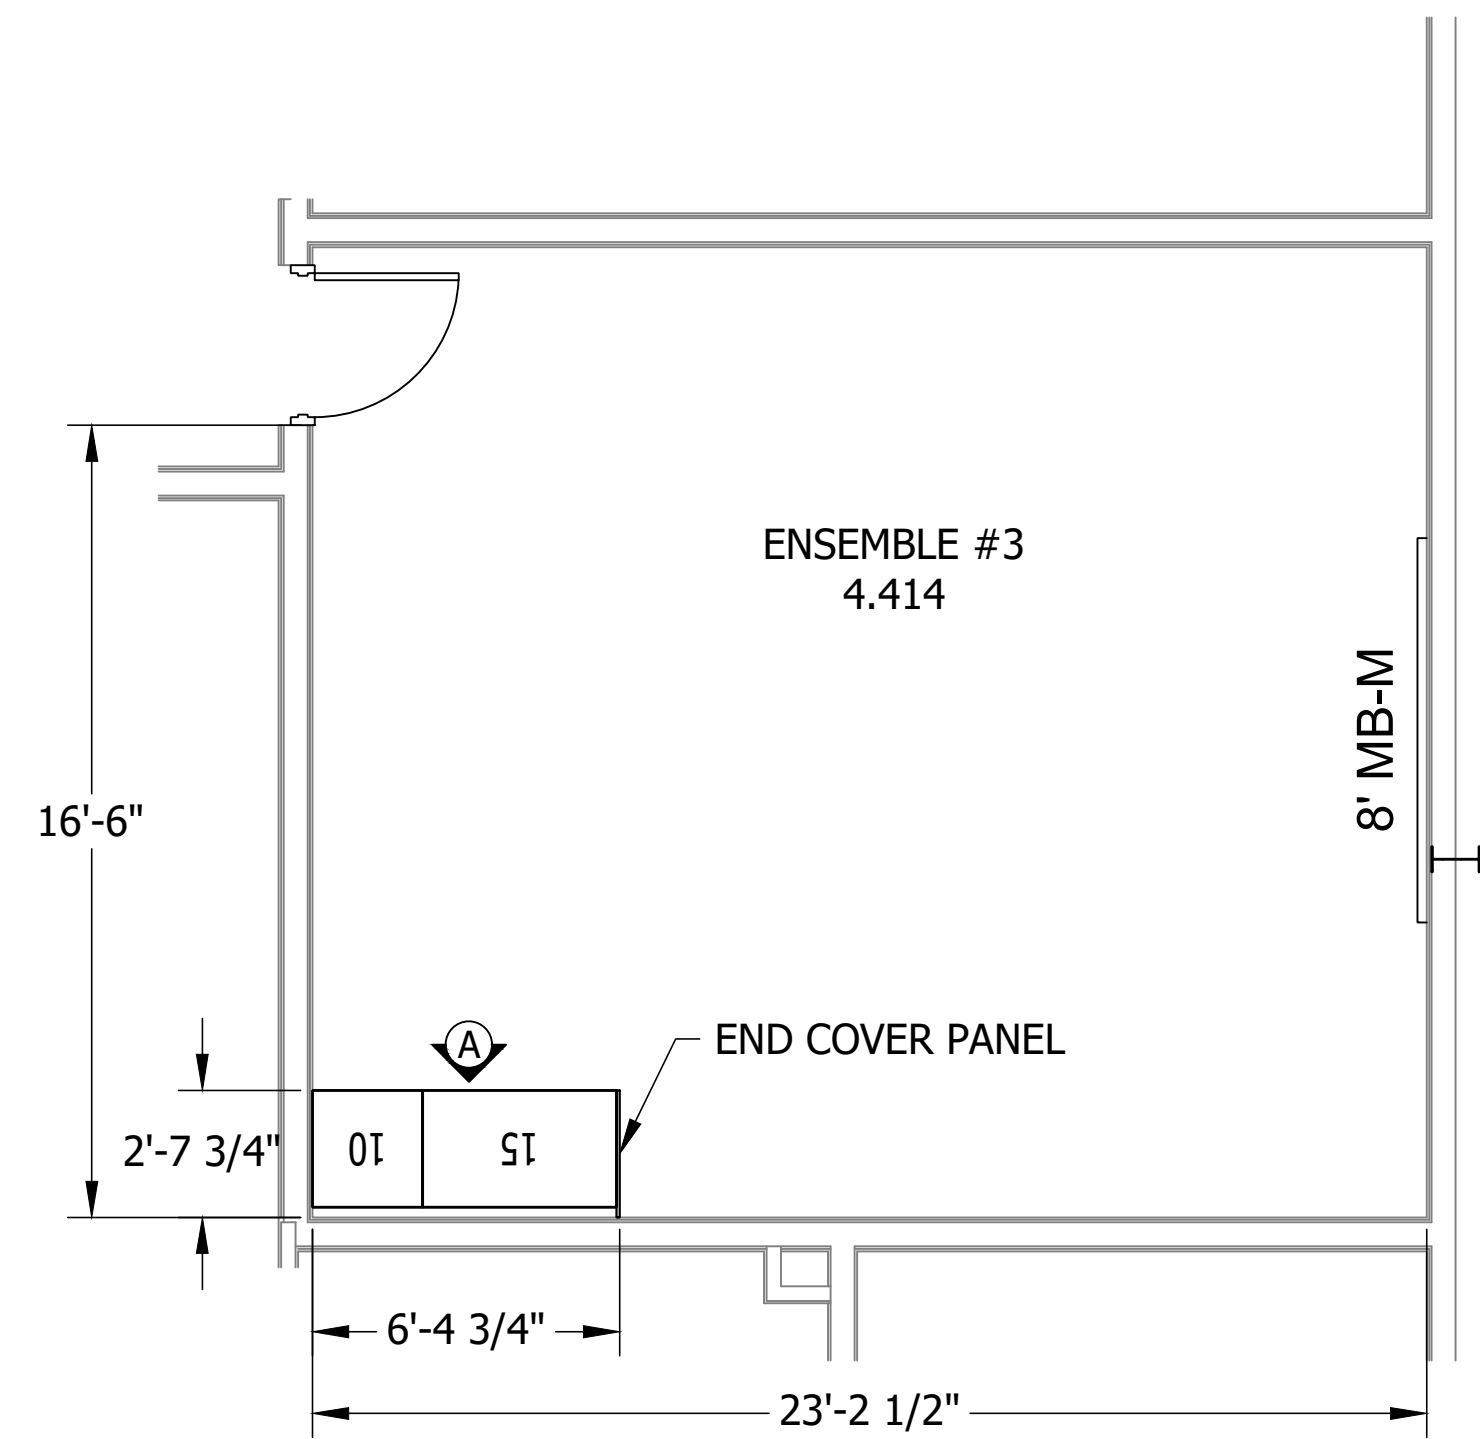

VIEW "A"

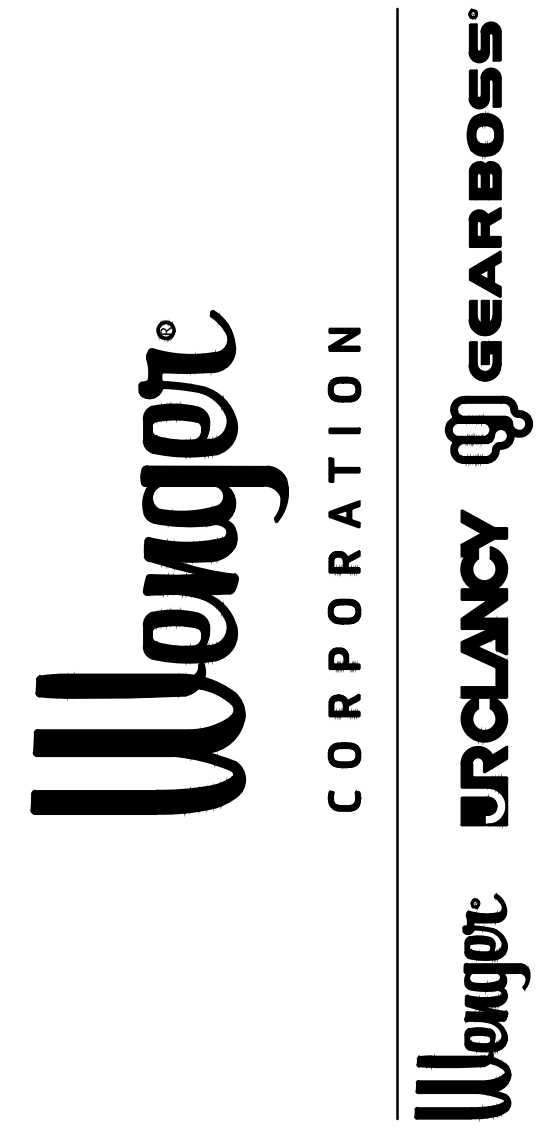

THIS DRAWING AND RELATED SPECIFICATIONS ARE CONFIDENTIAL AND PROPRIETARY TO THE WENGER CORPORATION. COPYRIGHT 2019 WENGER CORPORATION ALL RIGHTS RESERVED


- REVIEWED AND APPROVED
- REVISE AND RESUBMIT
- REVIEWED AND APPROVED WITH COMMENTS

SIGNATURE _____ DATE _____

Aledo Middle School
ALEDO TX, 76008

ARCHITECT:
CONSULTANT:
CONTRACTOR:

FINISH: WEIGHT: GENERIC:

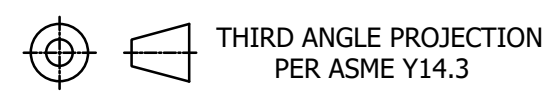

DRAWING TITLE:
ENSEMBLE #3 4.414 -
ACOUSTICABINET LAYOUT

PROJECT NUMBER:
20323131




SCALE: DO NOT SCALE DRAWING
DATE 07/28/20 DRN BY VW CHK BY CZ APVD BY CZ

DRAWING NUMBER: **20P29663-3** REV: **2**


BOX A	CABINETS TO HAVE WATERFALL COMPARTMENT GRILLE DOORS. COLOR TO MATCH HARDWARE AS INDICATED IN <u>BOX B</u> .
BOX B	CABINET COLOR COMBINATION TO BE SELECTED FROM WENGER STANDARD COLOR COMBINATIONS. COLOR COMBINATION SELECTED _____
BOX C	CABINETS TO BE CONSTRUCTED OF NO ADDED FORMALDEHYDE COMPOSITE WOOD.

EXISTING WENGER PRODUCTS - TO BE RELOCATED


QTY.	DESCRIPTION
5	#01 CABINET
5	#04 CABINET
4	#05 CABINET
7	#10 CABINET
6	#11 CABINET
1	#12 CABINET
28	TOTAL

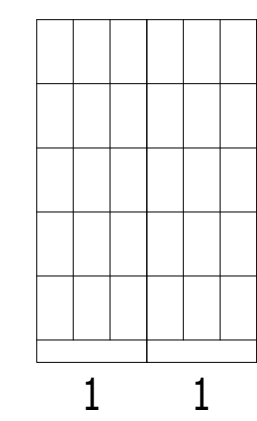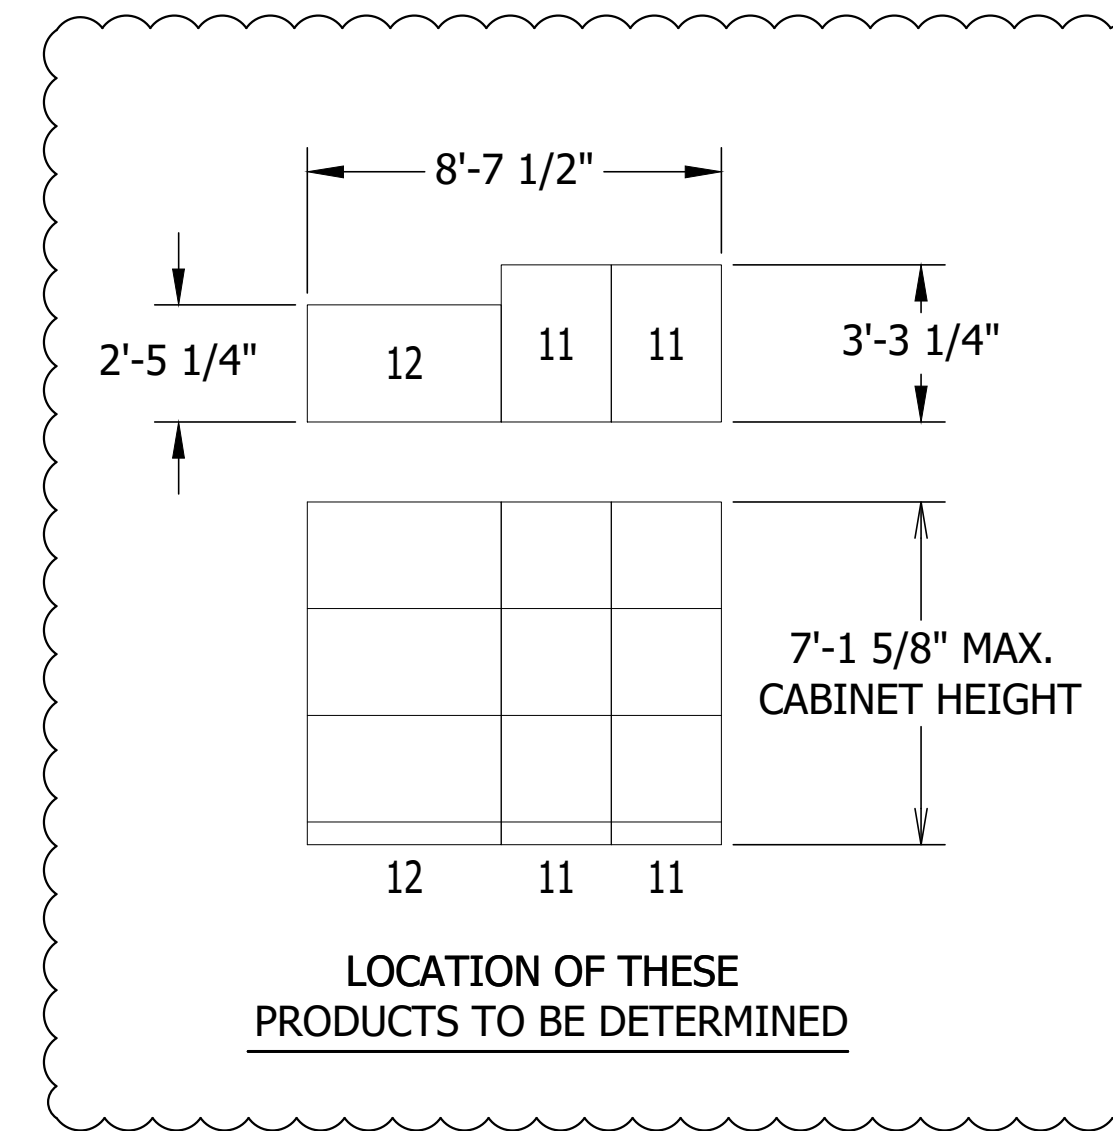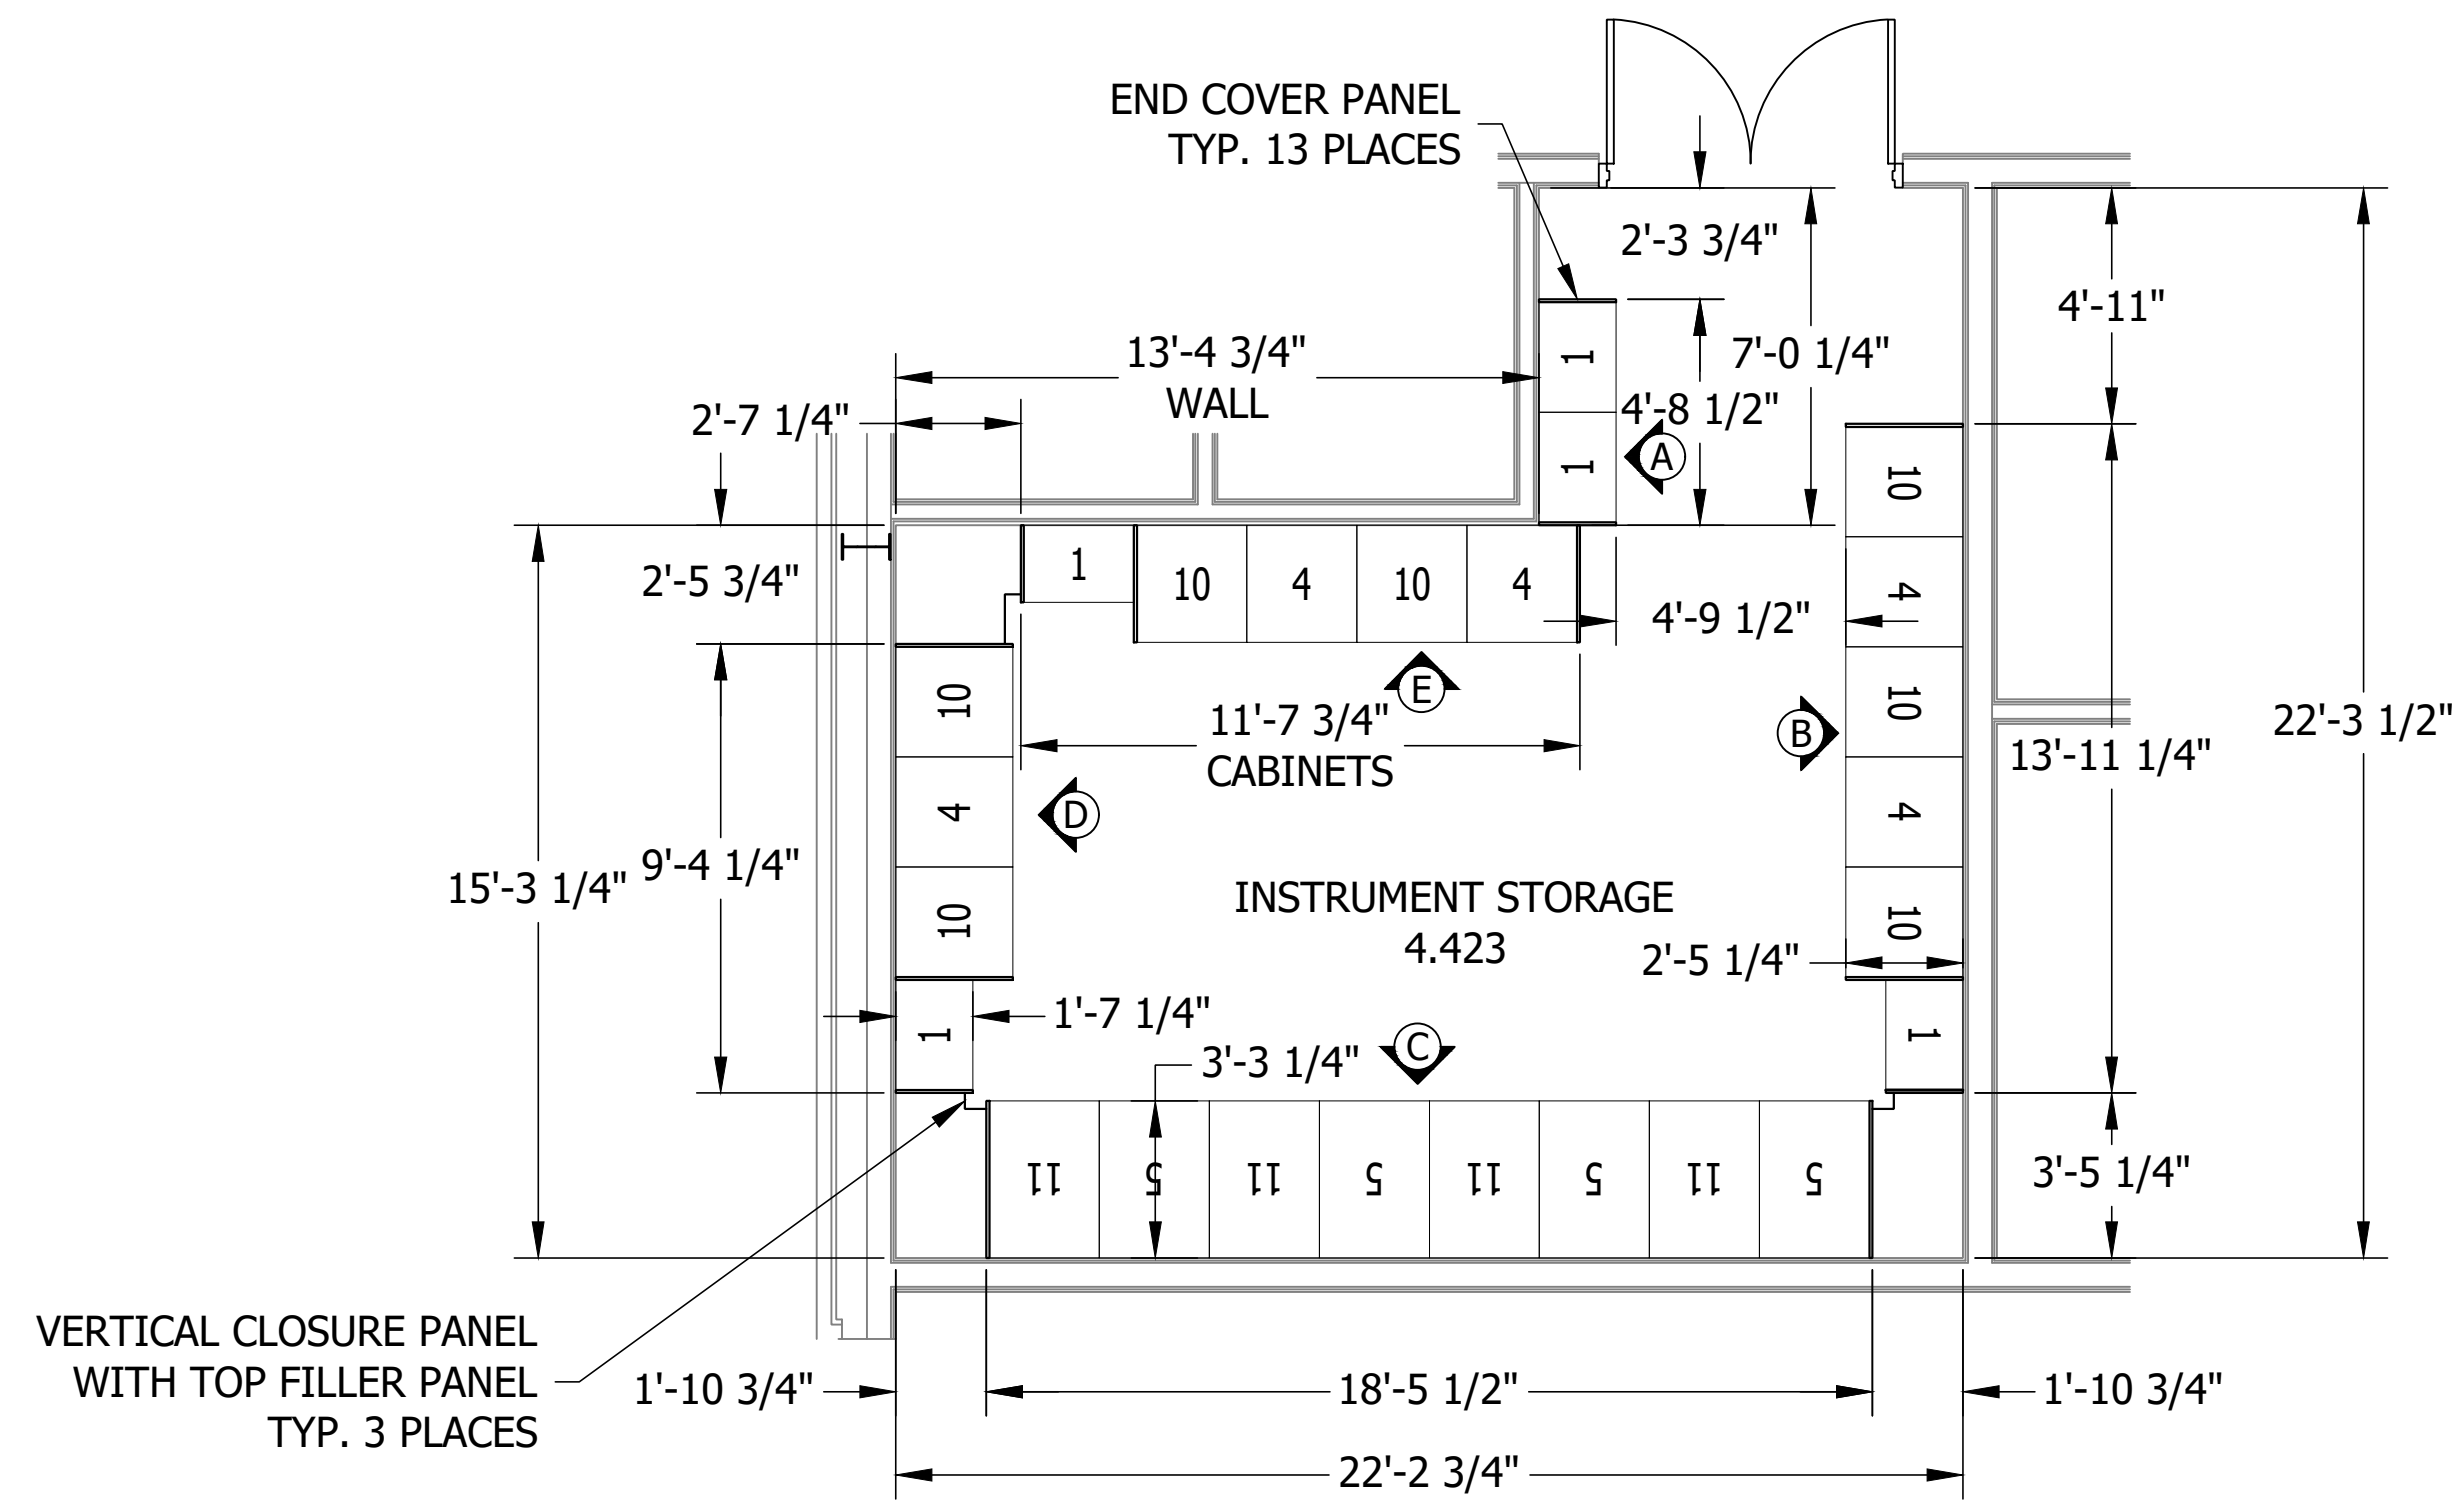


VIEW "A"

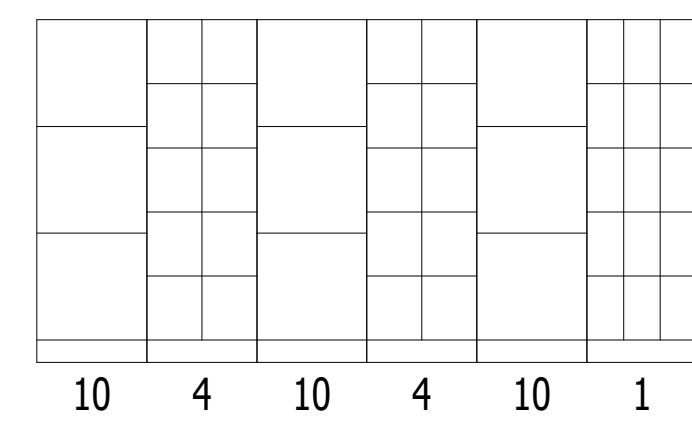


VIEW "B"

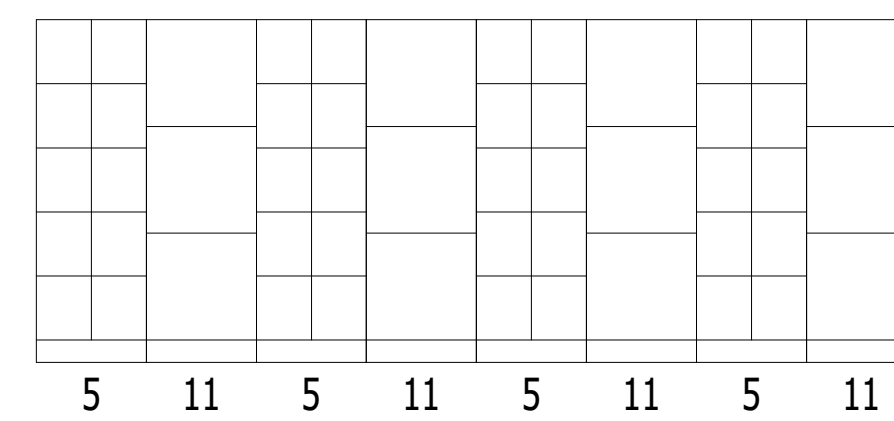

VIEW "C"

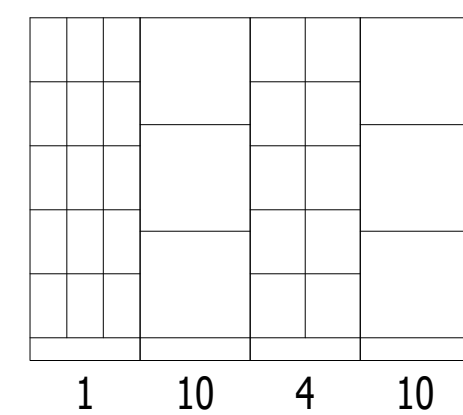

VIEW "D"

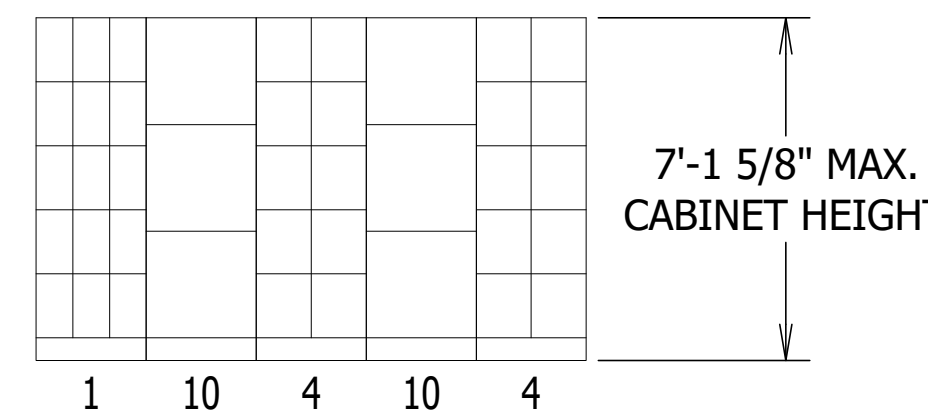

VIEW "E"

BOX A	CABINETS TO HAVE STRAIGHT COMPARTMENT GRILLE DOORS. COLOR TO MATCH HARDWARE AS INDICATED IN <u>BOX B</u> .
BOX B	CABINET COLOR COMBINATION TO BE SELECTED FROM WENGER STANDARD COLOR COMBINATIONS. COLOR COMBINATION SELECTED _____
BOX C	CABINETS TO BE CONSTRUCTED OF NO ADDED FORMALDEHYDE COMPOSITE WOOD.

THIS DRAWING AND RELATED SPECIFICATIONS ARE CONFIDENTIAL AND PROPRIETARY TO THE WENGER CORPORATION. COPYRIGHT 2019 WENGER CORPORATION. ALL RIGHTS RESERVED.

REVIEWED AND APPROVED _____ DATE _____

REVISE AND RESUBMIT _____

REVIEWED AND APPROVED WITH COMMENTS _____

SIGNATURE _____

Aledo Middle School

ALEDO TX, 76008

ARCHITECT:

CONSULTANT:

CONTRACTOR:

FINISH: WEIGHT: GENERIC:

THIRD ANGLE PROJECTION PER ASME Y14.3

DRAWING TITLE:
INSTRUMENT STORAGE 4.423 - CABINET LAYOUT

PROJECT NUMBER:

20323131

SCALE: DO NOT SCALE DRAWING

DATE	DRN BY	CHK BY	APVD BY
07/28/20	VW	CZ	

DRAWING NUMBER: REV:

20P29663-4 2