

December 3, 2025

Mr. William Green  
Assistant Superintendent of District Services  
Livonia Public Schools  
15125 Farmington Road  
Livonia, MI 48154

RE: 2021 Bond Program  
Recommendation for 2026 LMC Furniture Purchase - Partial  
Niji-Iro Elementary / Webster Elementary

Dear Mr. Green:

This letter transmits an update from Plante Moran Realpoint (PMR) as it relates to the assignment to assist and advise Livonia Public Schools (LPS) in its purchase of furniture for the Projects listed above. This update represents the mutual efforts of PMR, French Associates, and LPS administration and staff (the Team).

Coinciding with ongoing design efforts to renovate and reimagine LMC spaces as part of the 2021 Bond Program, the Team has conducted multiple meetings and site visits over the course of the past few months focused on the selection of furniture to best serve each space. While decisions around the balance of 2026 LMC sites remain ongoing, the Team is driven to expedite the purchase of items provided by Media Technologies for each site specifically due to current material procurement timelines and efforts to streamline installation of the items upon completion of renovation activities.

The Team recommends awarding **NBS Commercial Interiors** to supply and install the referenced LMC furniture pieces in an amount not-to-exceed **\$75,750.00** as further detailed below and within French's recommendation documents.

Niji-Iro Elementary School	\$32,649.14
Webster Elementary School	\$39,493.49
<hr/>	
NBS Quotation	\$72,142.63
Contingency (5%)	\$3,607.37
<hr/>	
<b>Award Recommendation (NTE)</b>	<b>\$75,750.00</b>

For the Vendor, the pricing for this work will be detailed in a Purchase Order Agreement, pending final review and approval of terms by district legal counsel.

The Team is available at the Board's convenience to answer any questions regarding this recommendation. Please direct all questions through me via email at [brian.weber@plantemoran.com](mailto:brian.weber@plantemoran.com).

Sincerely,

PLANTE MORAN REALPOINT



Brian Weber  
Senior Vice President

Enclosures: French Associates Recommendation Letter  
Product Information & Layout  
Vendor Proposals



2851 High Meadow Circle | Suite 100  
Auburn Hills | MI 48326  
248.656.1377 | [www.frenchaia.com](http://www.frenchaia.com)

December 1<sup>st</sup>, 2025

William Green  
Asst. Superintendent of District Services  
Livonia Public Schools

**Subject: 2021 Bond Program – 2025 Renovations  
Media Center Furniture**

Dear Mr. Green,

French has been consulting with NBS Commercial Interiors in the development and programming of furniture for the 2021 Bond Program projects. Throughout the design process, NBS has aided in product selections, availability, and lead times.

On November 26<sup>th</sup>, 2025, French Associates received furniture quotes from NBS Commercial Interiors for all items being supplied by Media Technologies for the Media Centers and Idea Factories at Niji-Iro Japanese Immersion Elementary and Webster Elementary. These items are to be ordered early to ensure on time manufacturing and stored at Media Technologies free of charge until summer of 2026 installation.

Enclosed are the furniture quotes that utilize the NCPA consortium group pricing. The totals for these projects are as follows:

Niji-Iro Japanese Immersion Elementary: \$32,649.14  
Webster Elementary: \$39,493.49

**French is recommending award to NBS Commercial Interiors for the procurement and installation of furniture in the Media Centers and Idea Factories listed above in the total amount of \$72,142.63.**

Please contact me if you have any questions.

Sincerely,

Jessica Walter  
Interior Designer



- MOBILE DESK
- MOBILE PEDESTAL
- CENTER DRAWER


CIRCULATION DESK



- MOBILE BOOK RETURN
- NO SLOT
- BOOK TRUCK




BOOK DISPLAY

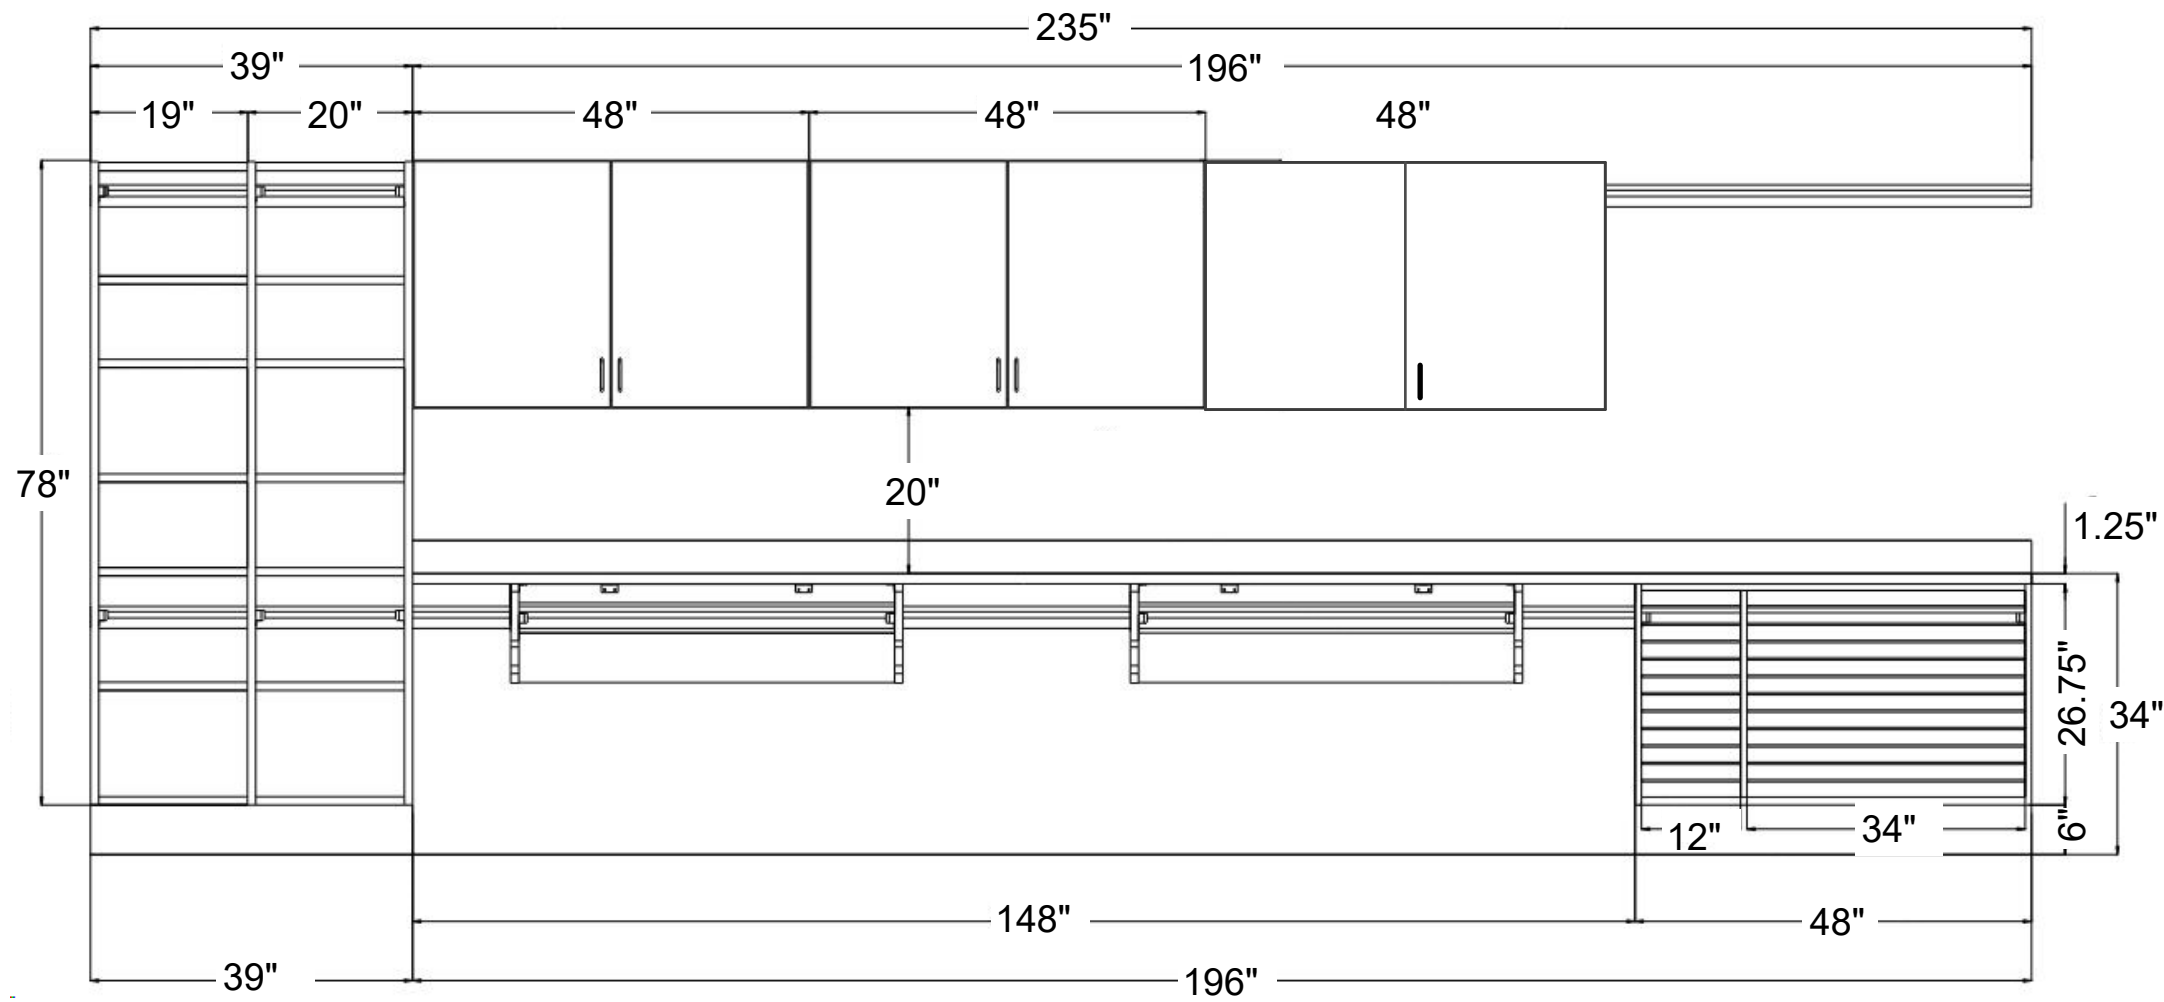


ELEVATION - IDEA FACTORY CASEWORK A131


\*\*FIELD MEASURE NEEDED\*\*

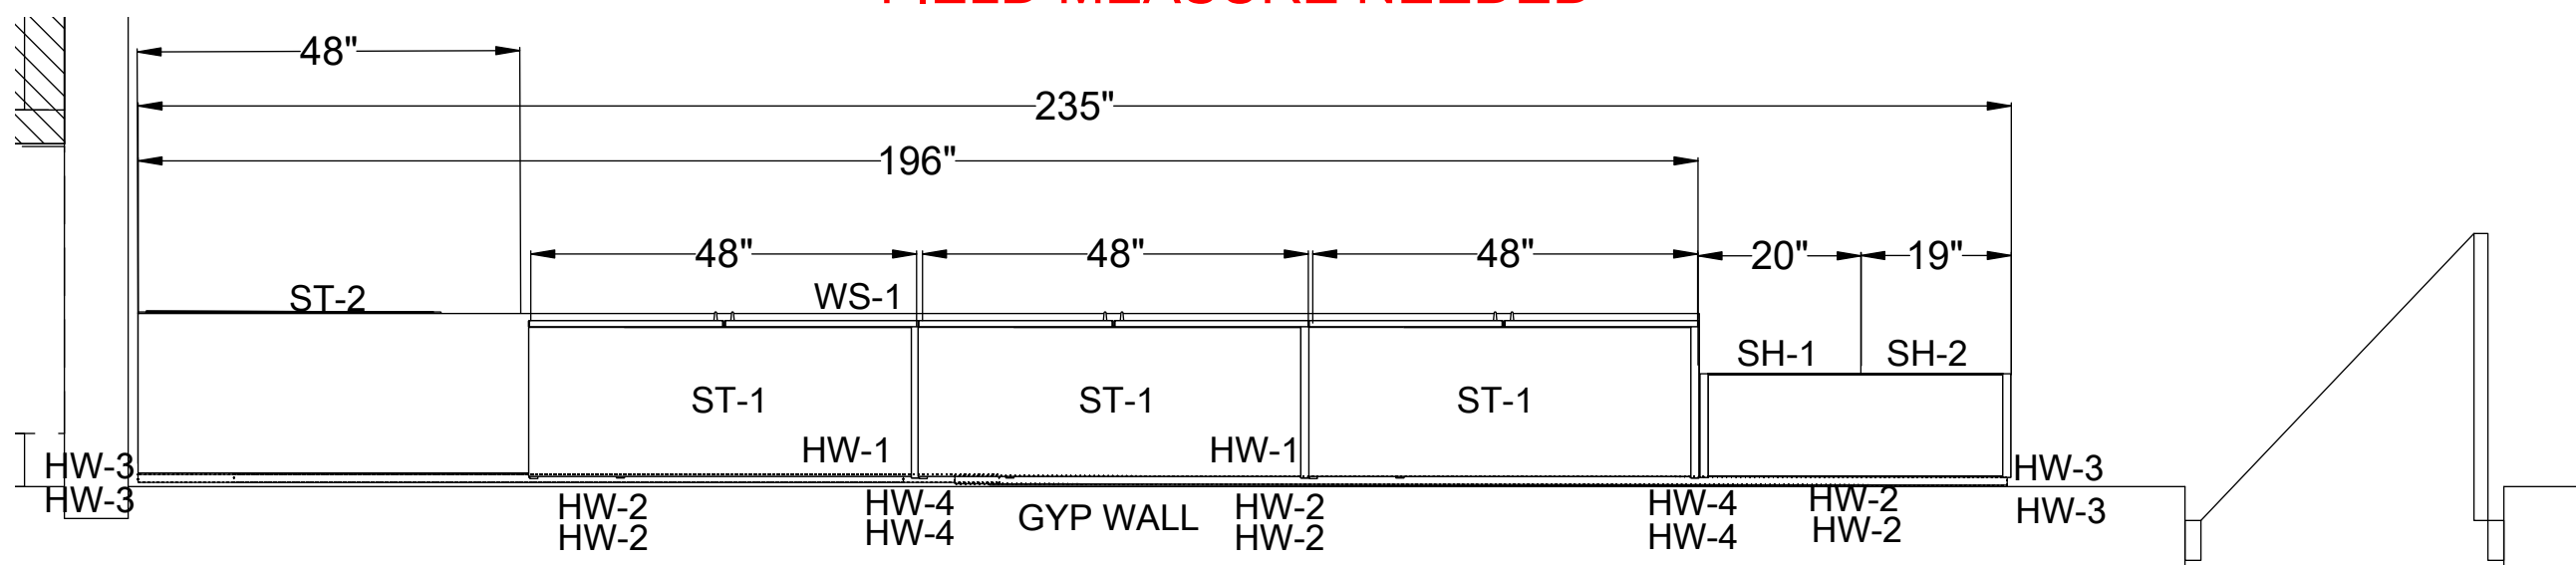


ENLARGED PLAN - IDEA FACTORY CASEWORK A131

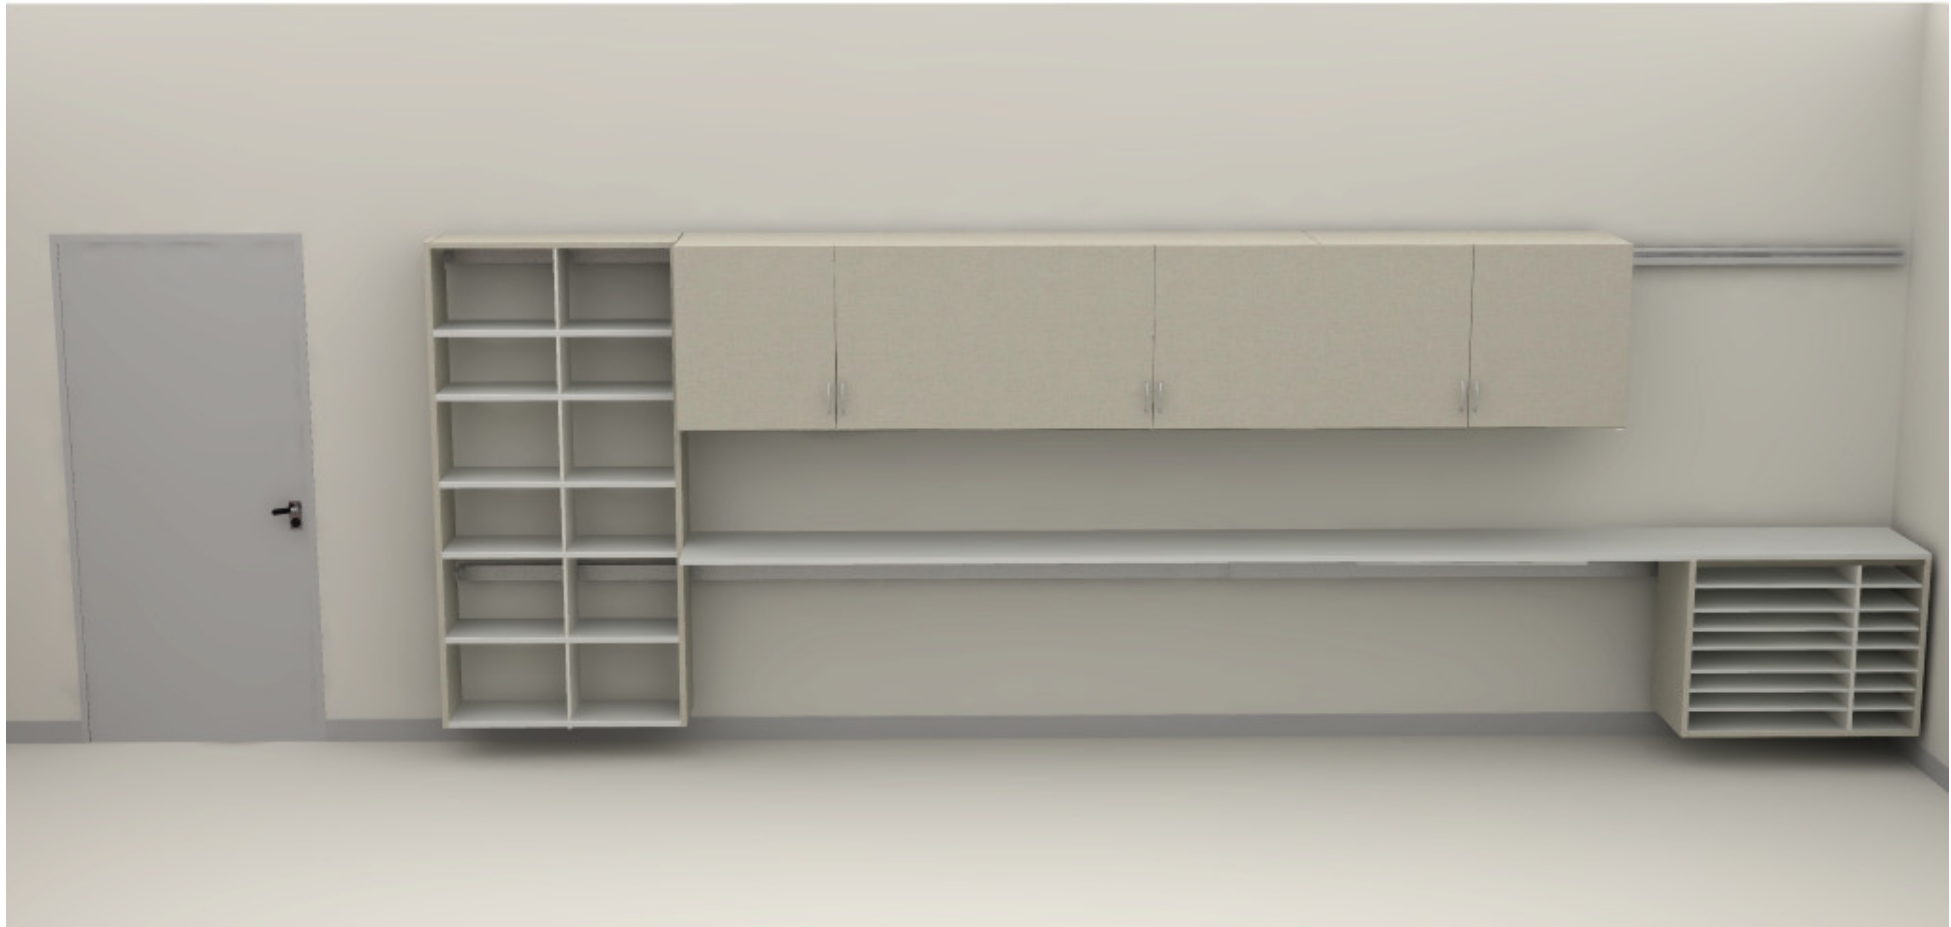

\*\*FINISHES TBD\*\*

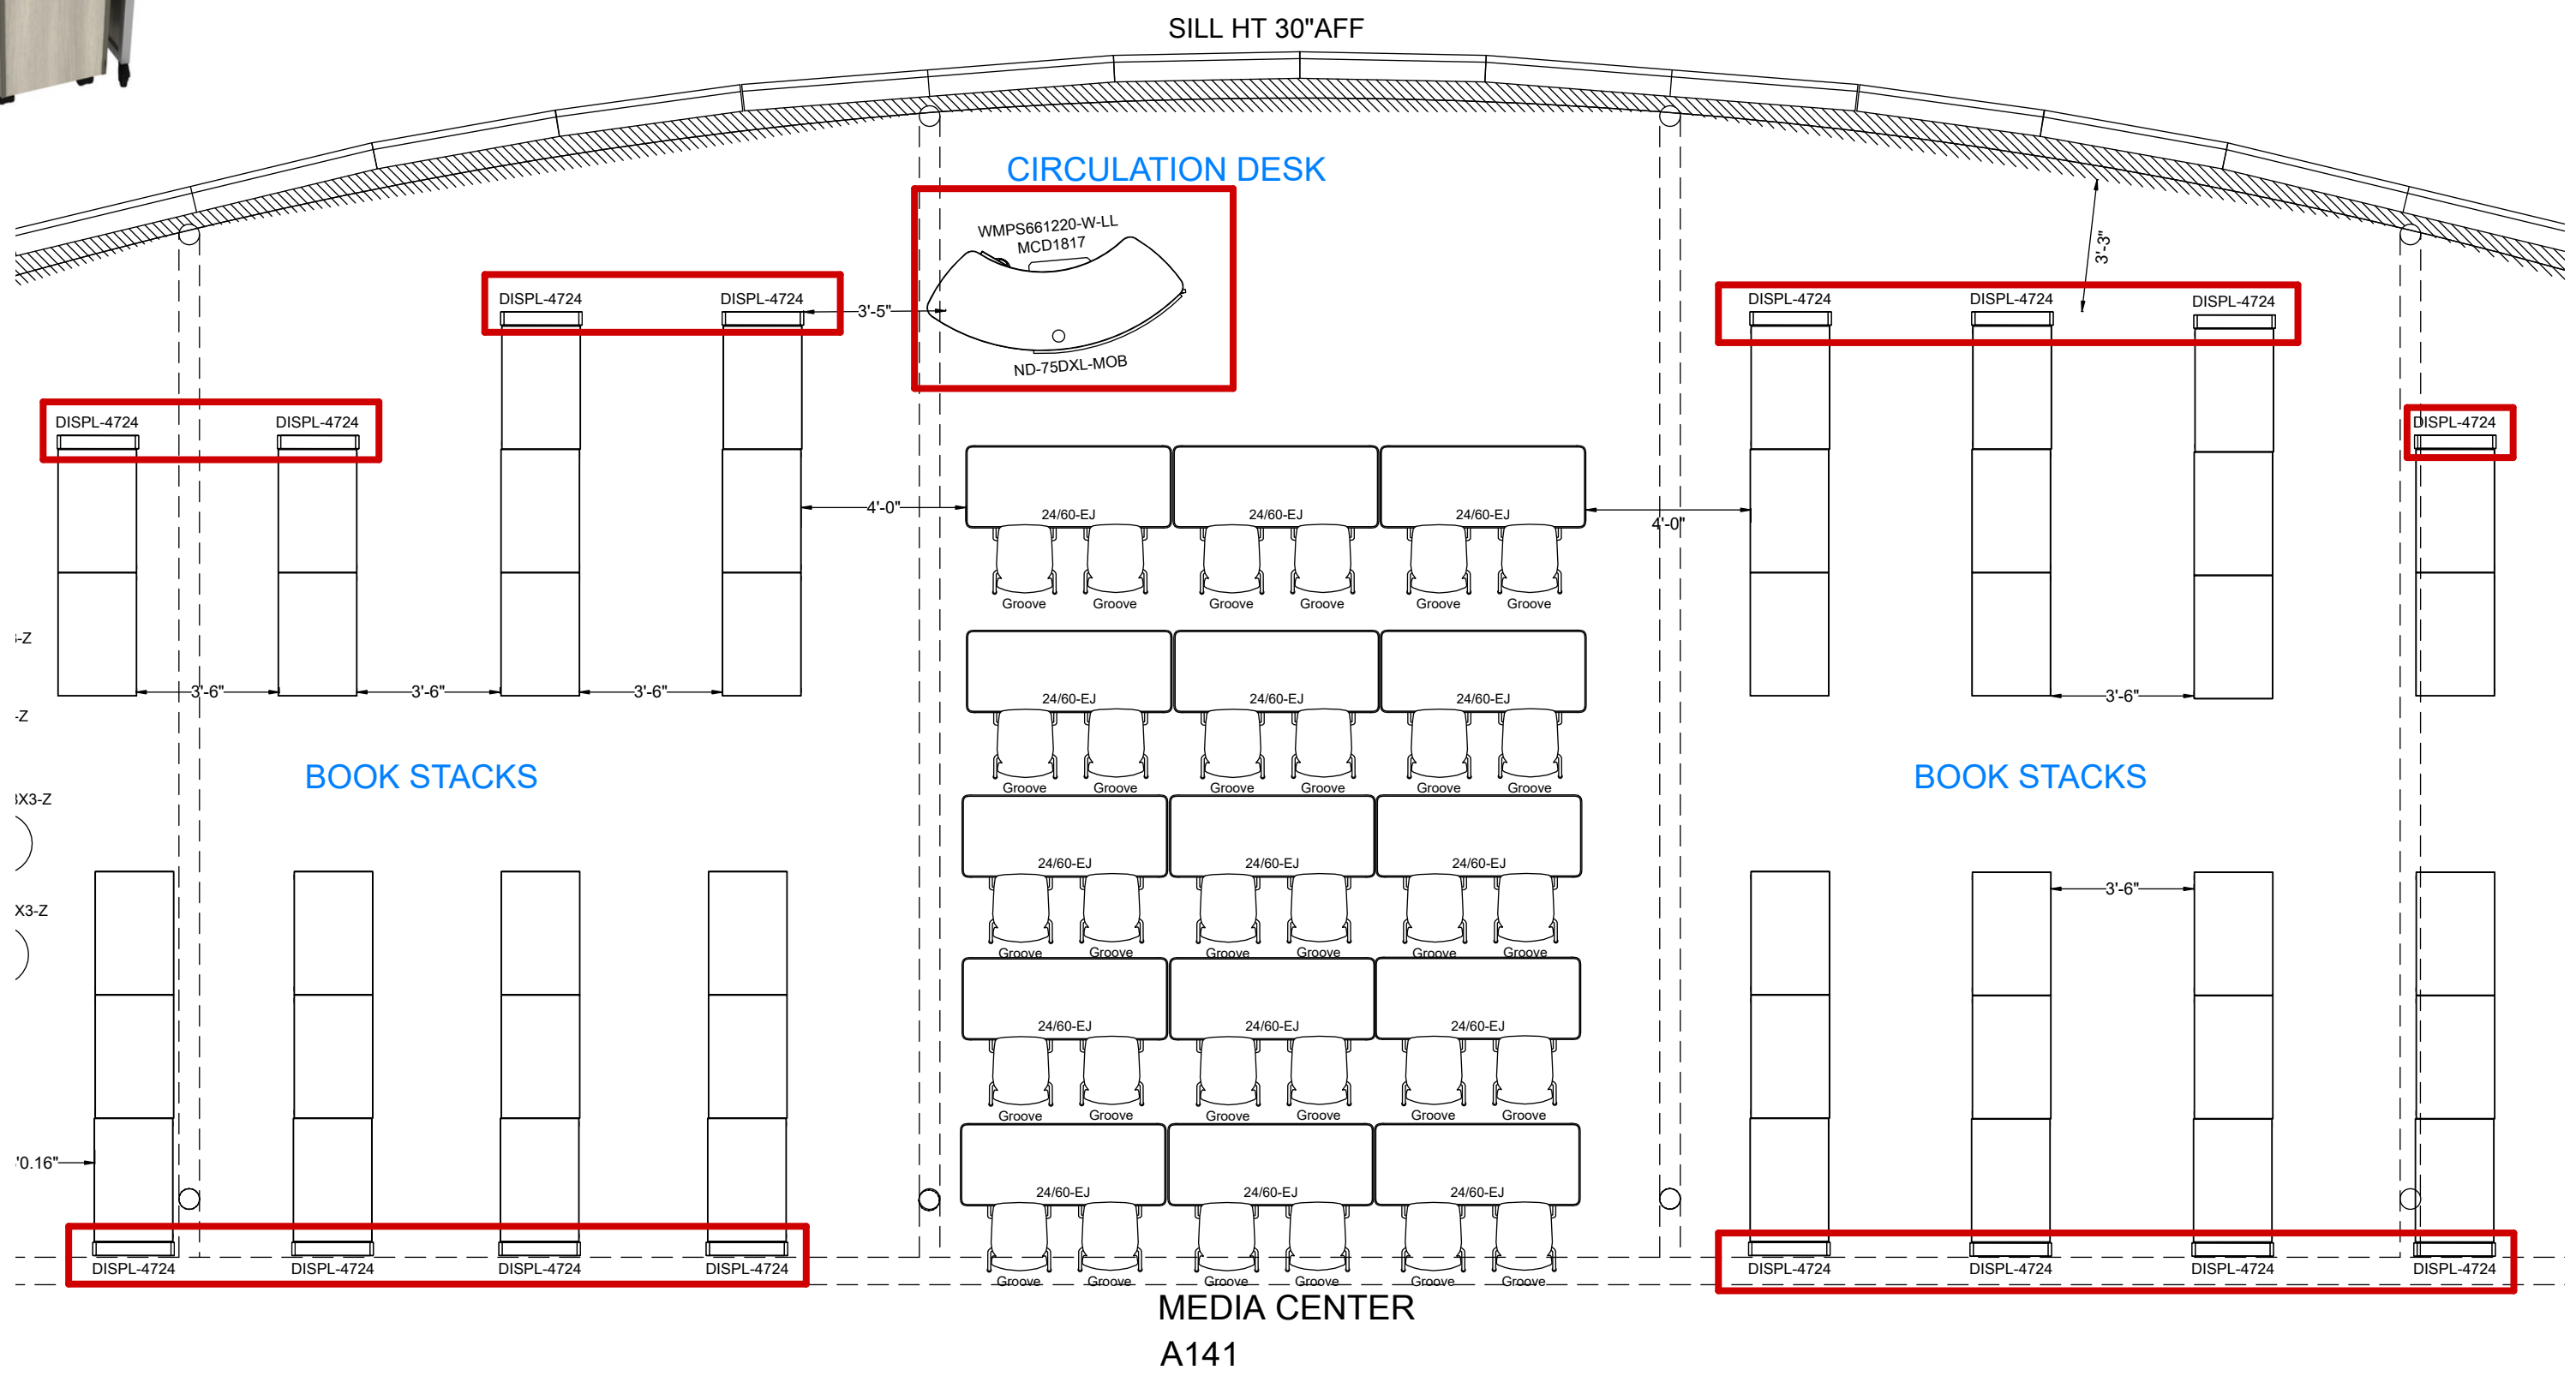

FLOOR PLAN - MEDIA CENTER A141

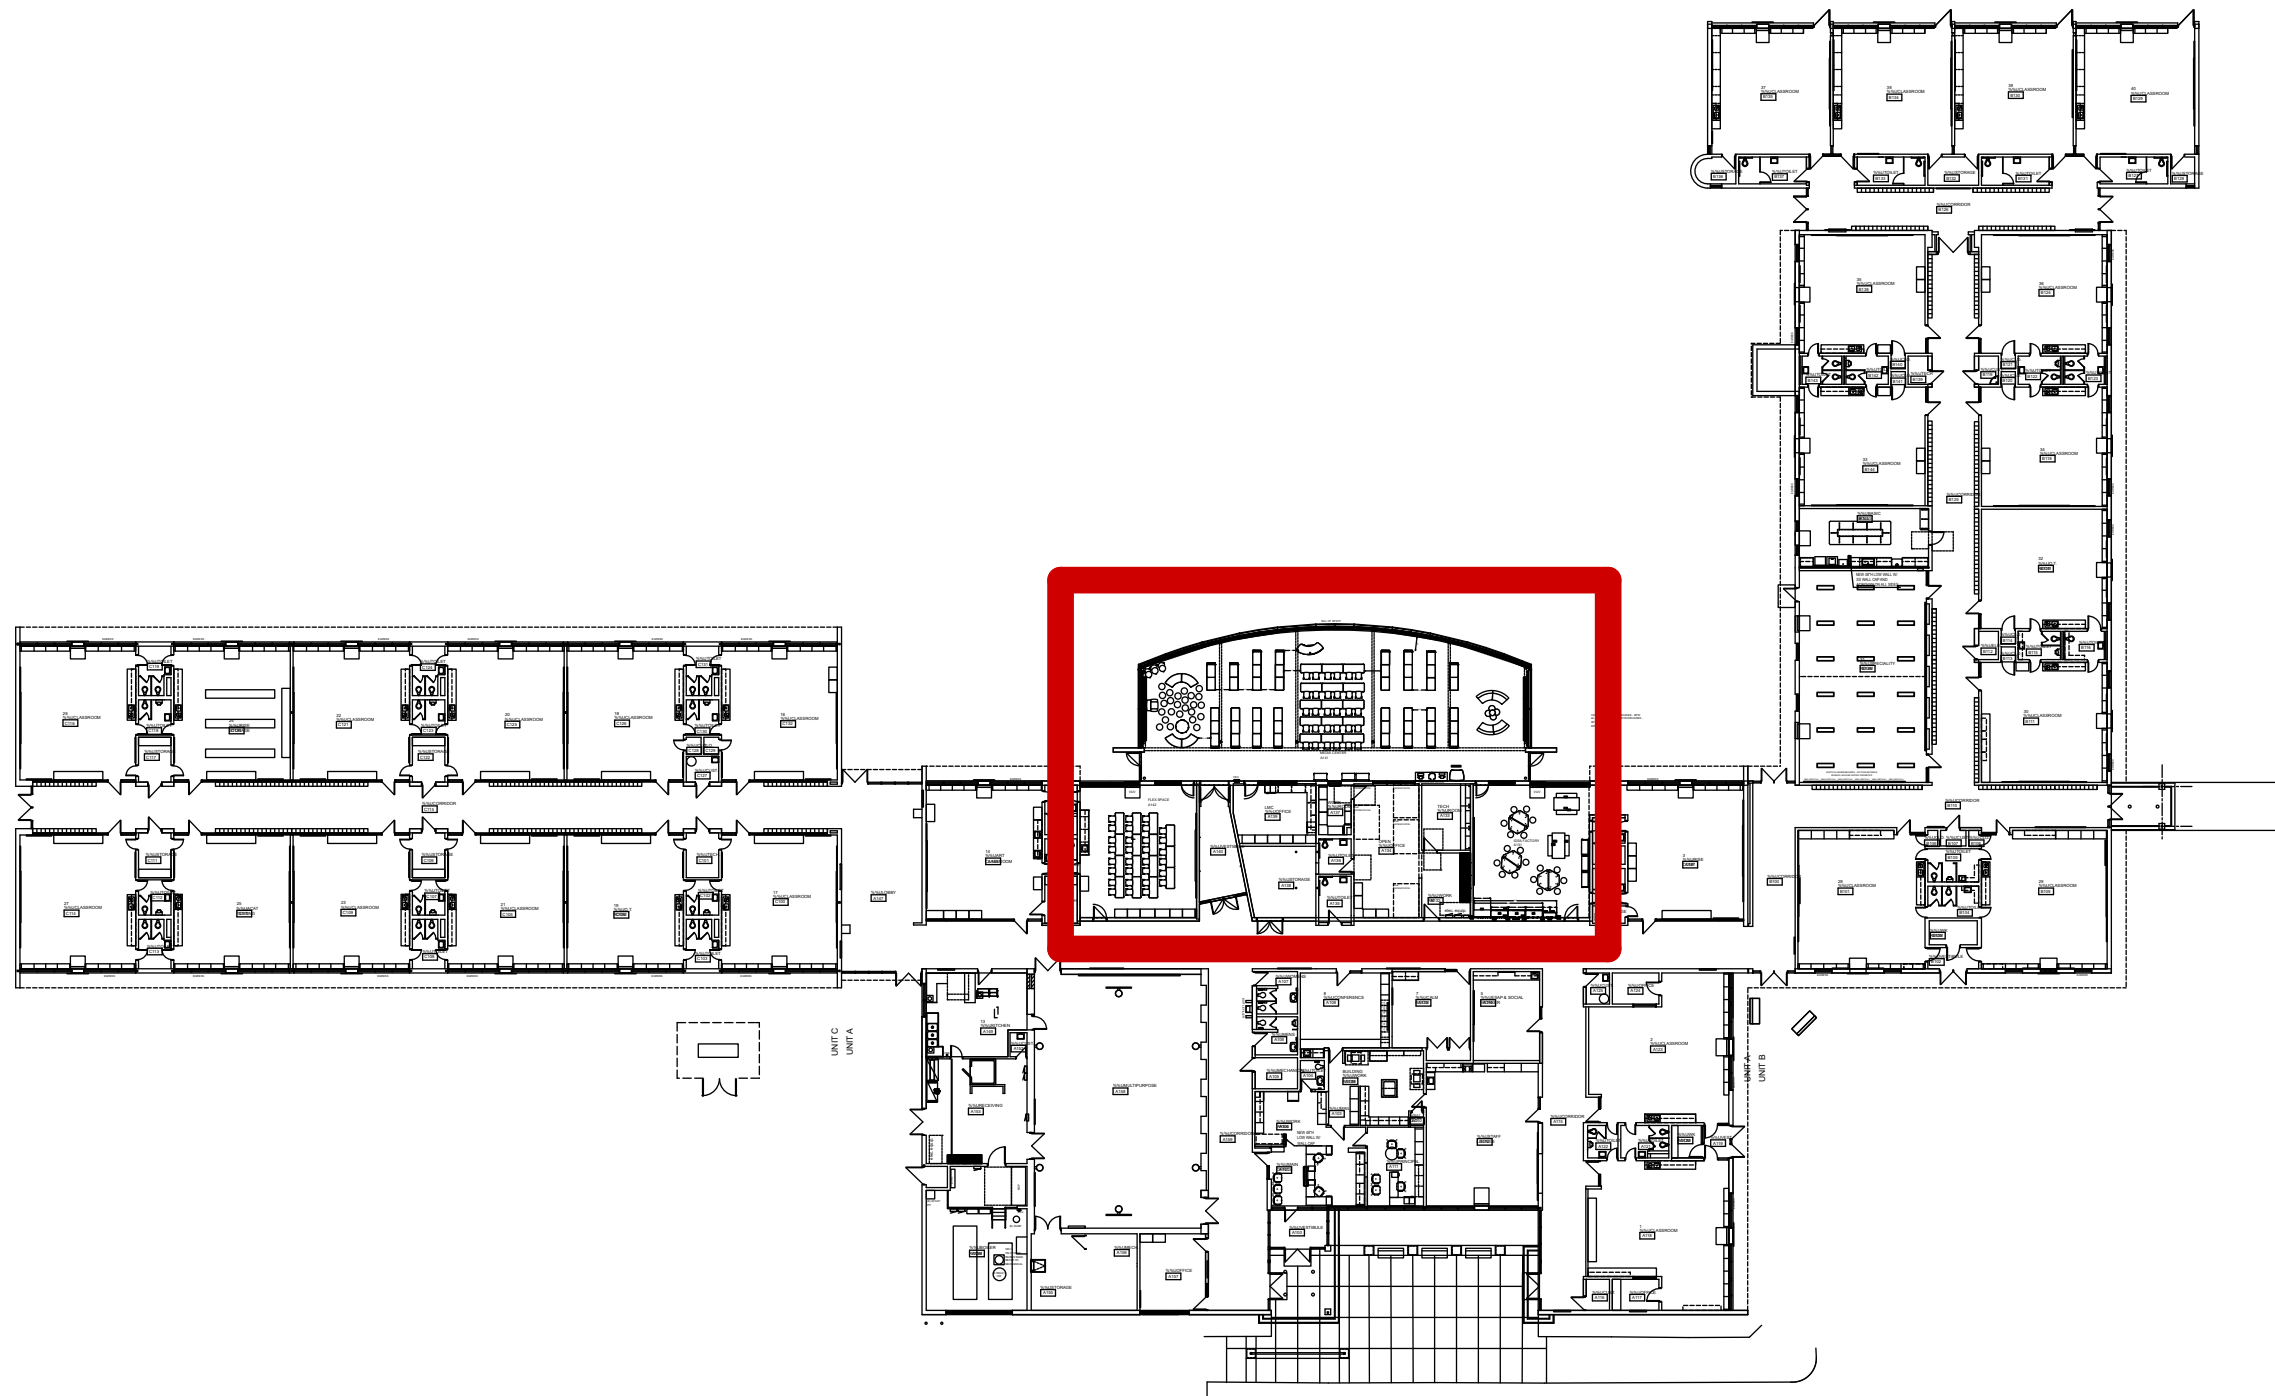

**MEDIA TECH ONLY**  
**MEDIA CENTER + IDEA FACTORY**  
**AUDIT Q#395795**

NCIDQ SEAL:

GENERAL NOTES:  
NOT FOR CONSTRUCTION  
ALL STRUCTURAL, MECHANICAL & ELECTRICAL ENGINEERING IS THE RESPONSIBILITY OF OTHERS.  
ALL FURNITURE & DESIGN DRAWINGS ARE IN CONFIDENCE & DISSEMINATION MAY NOT BE MADE WITHOUT PRIOR WRITTEN CONSENT OF NBS. ALL COMMON LAW RIGHTS OF COPYRIGHT AND OTHERWISE ARE HEREBY SPECIFICALLY RESERVED.  
FINAL FURNITURE FIT & PLACEMENT IS SUBJECT TO ANY VARIATION FROM THIS PLAN DUE TO CONSTRUCTION CHANGES, FIELD CONDITIONS, MATERIAL DIFFERENCES OR CHANGES REQUIRED FOR ANY REASON WITH NOTIFICATION TO NBS.  
IF NBS DID NOT DESIGN THIS PROJECT, NBS DOES NOT ASSUME RESPONSIBILITY FOR THE DESIGN SPECIFICATION OF PARTS OR APPLICATION OF PRODUCTS INCLUDED IN THIS BID. NBS HAS ONLY RESPONDED TO THE PRICING REQUEST FOR THE

APPROVED BY:	DATE:
<b>NBS Project Approval</b> Signing off on this document signifies that the Client has reviewed and approves the drawing layout, products/application indicated, and finishes as shown on drawing.	
Client Signature	Date
<input type="checkbox"/> APPROVED	<input type="checkbox"/> APPROVED AS NOTED

11/18/25	MEDIA TECH AUDIT

OWNER:  
**LIVONIA PUBLIC SCHOOLS**

PROJECT:  
**WEBSTER ELEMMENTARY - MEDIA CENTER**


32401 PEMBROOKE  
LIVONIA, MI

PROJECT FOLDER: 251691  
HEDBERG ORDER #: TBD  
ACCOUNT MANAGER: M.DUGAN  
DESIGNER: S.MAZZARA  
PROJECT MANAGER F.KREN

DRAWING:  
**COMPONENT PLAN**


DRAWING NUMBER:  
**ID-3.1B**



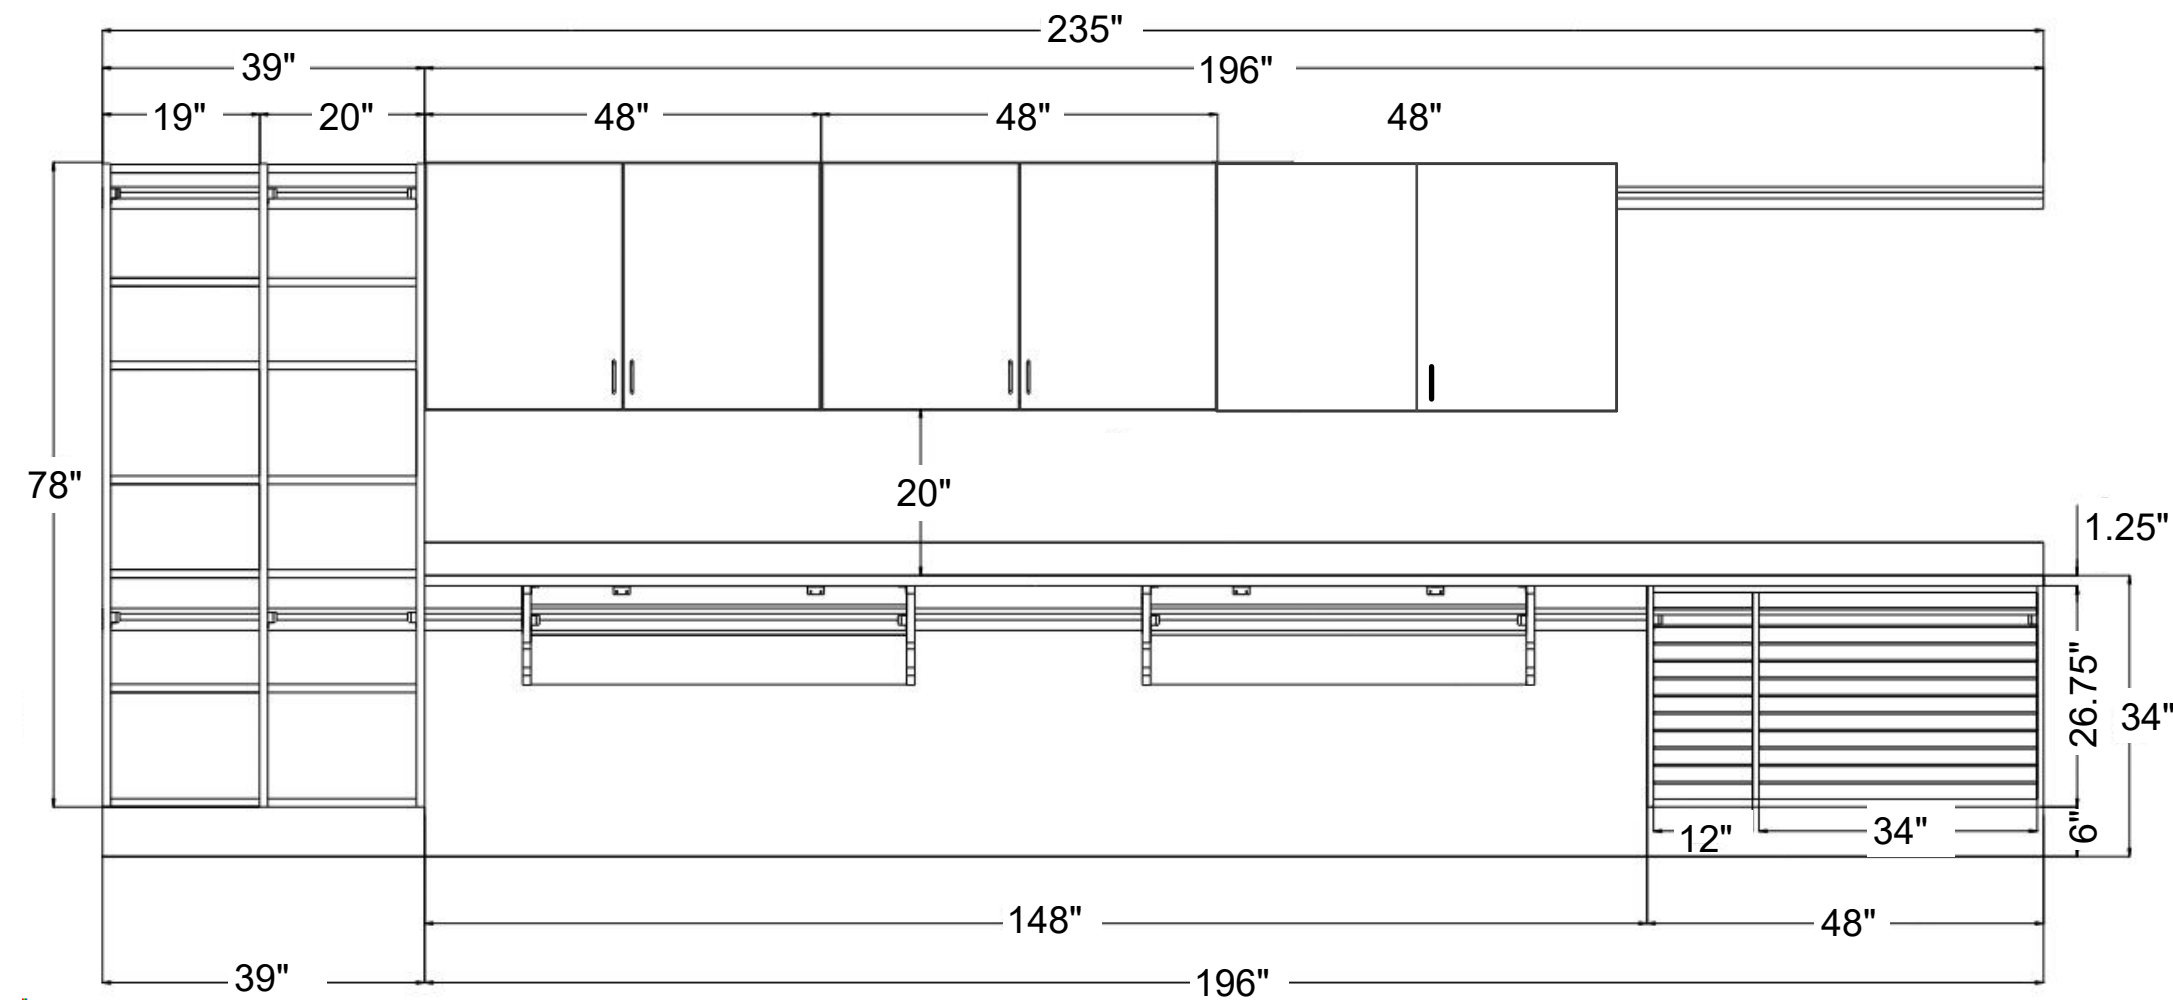

ELEVATION - IDEA FACTORY CASEWORK B148

**\*\*FIELD MEASURE NEEDED\*\***

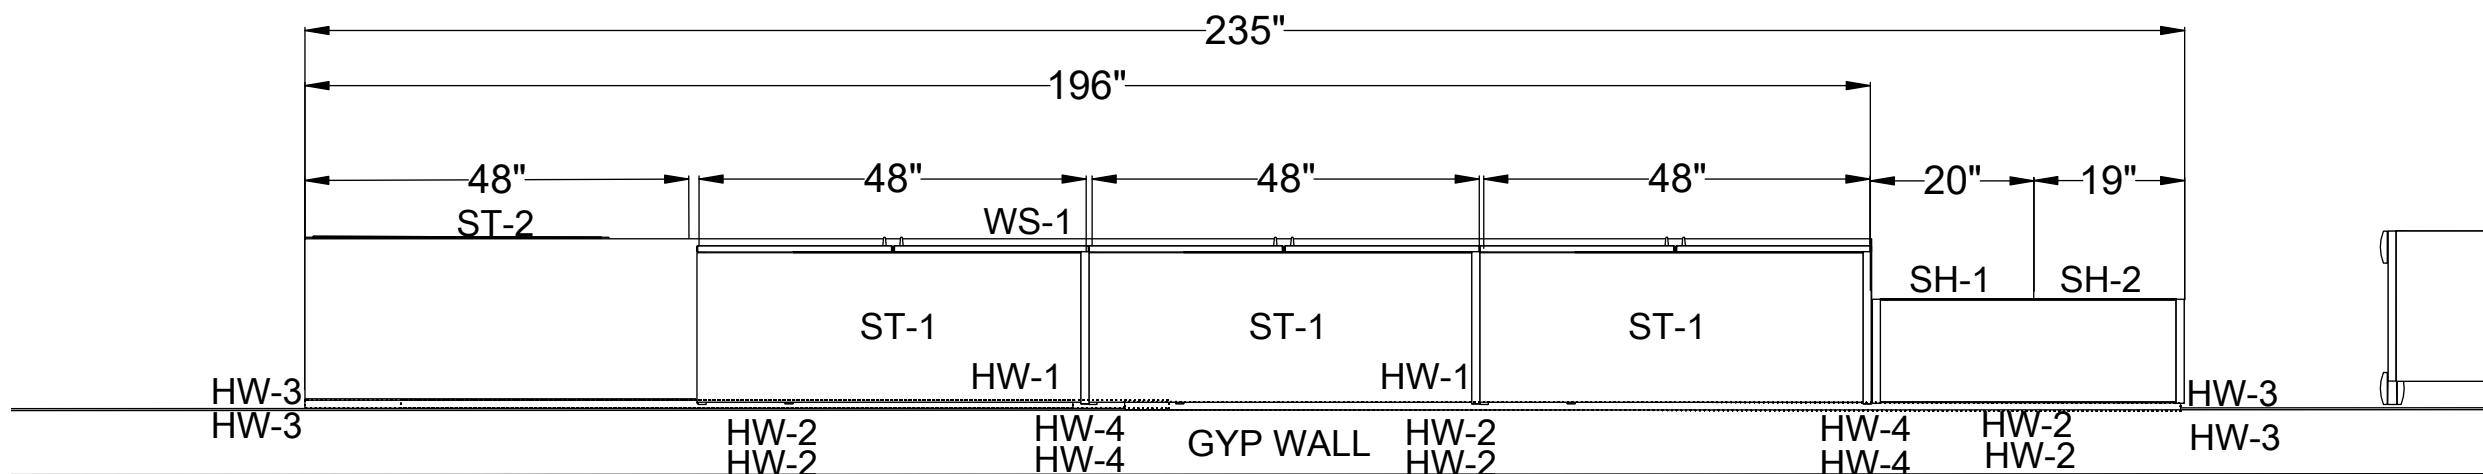

ENLARGED PLAN - IDEA FACTORY CASEWORK B148



**\*\*FINISHES TBD\*\***



- MOBILE DESK  
- MOBILE PEDESTAL  
- CENTER DRAWER


CIRCULATION DESK




- MOBILE BOOK RETURN  
- NO SLOT  
- BOOK TRUCK



BOOK DISPLAY

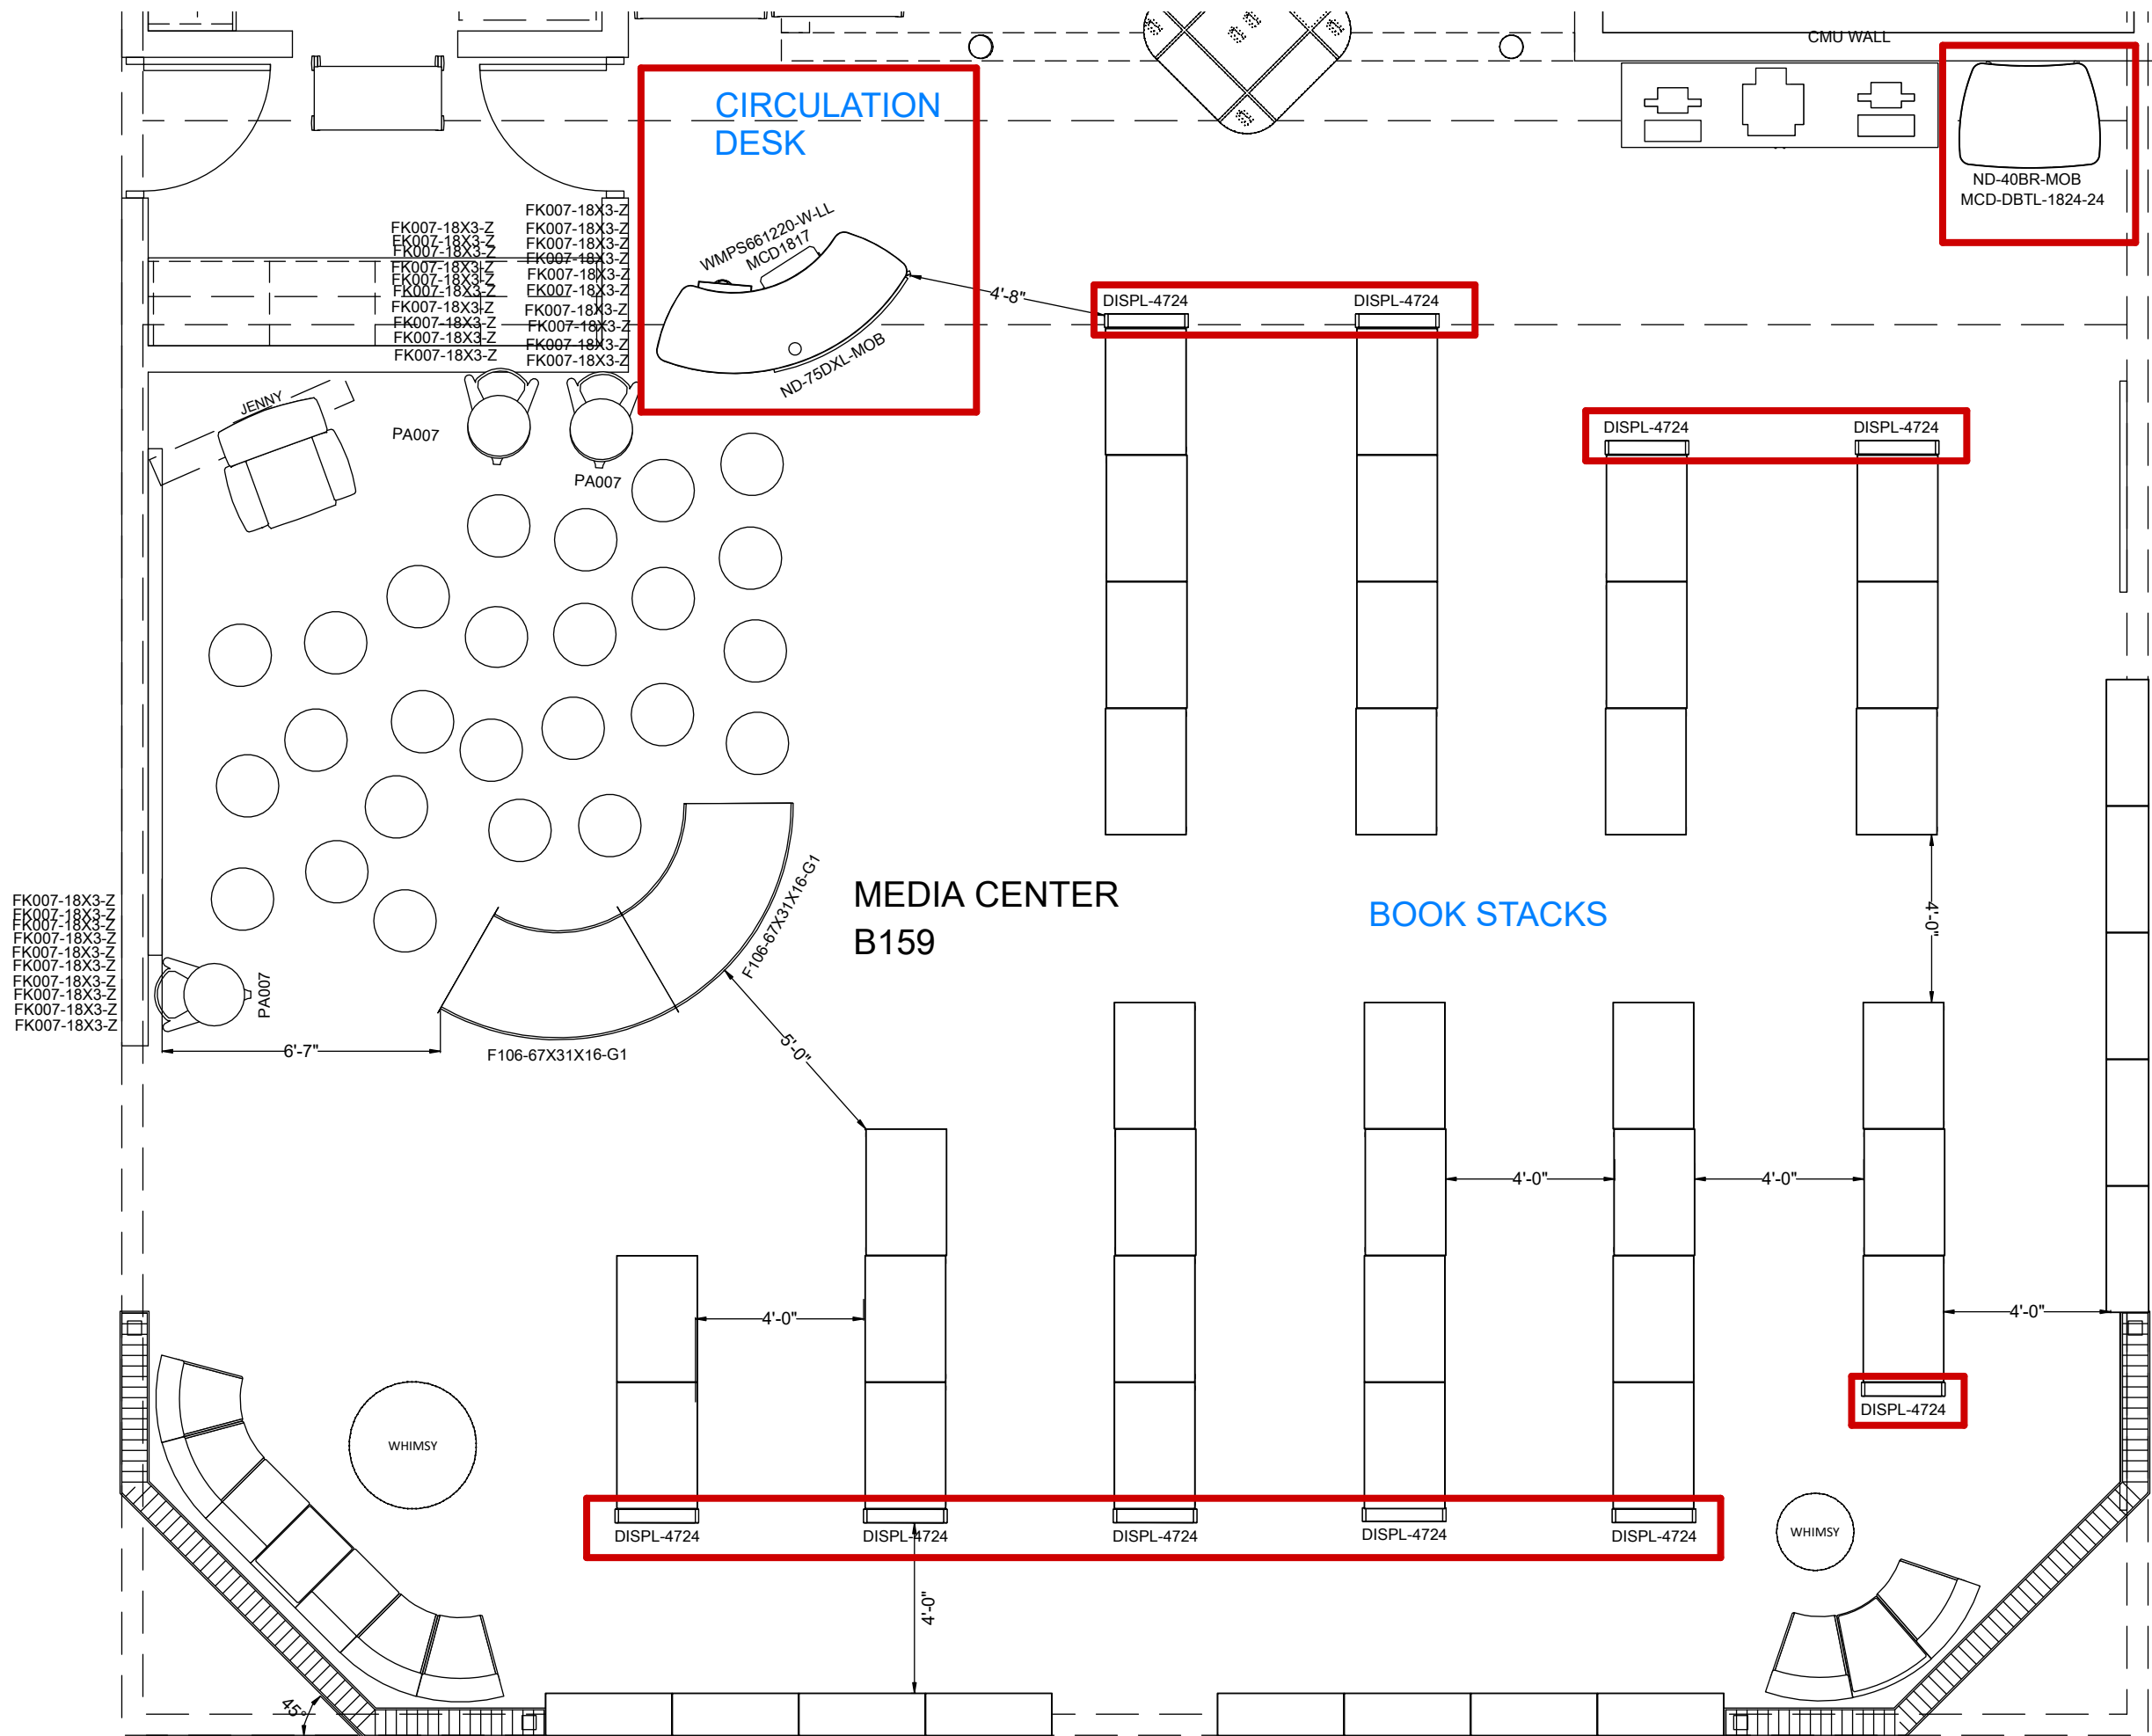

FLOOR PLAN - MEDIA CENTER B159

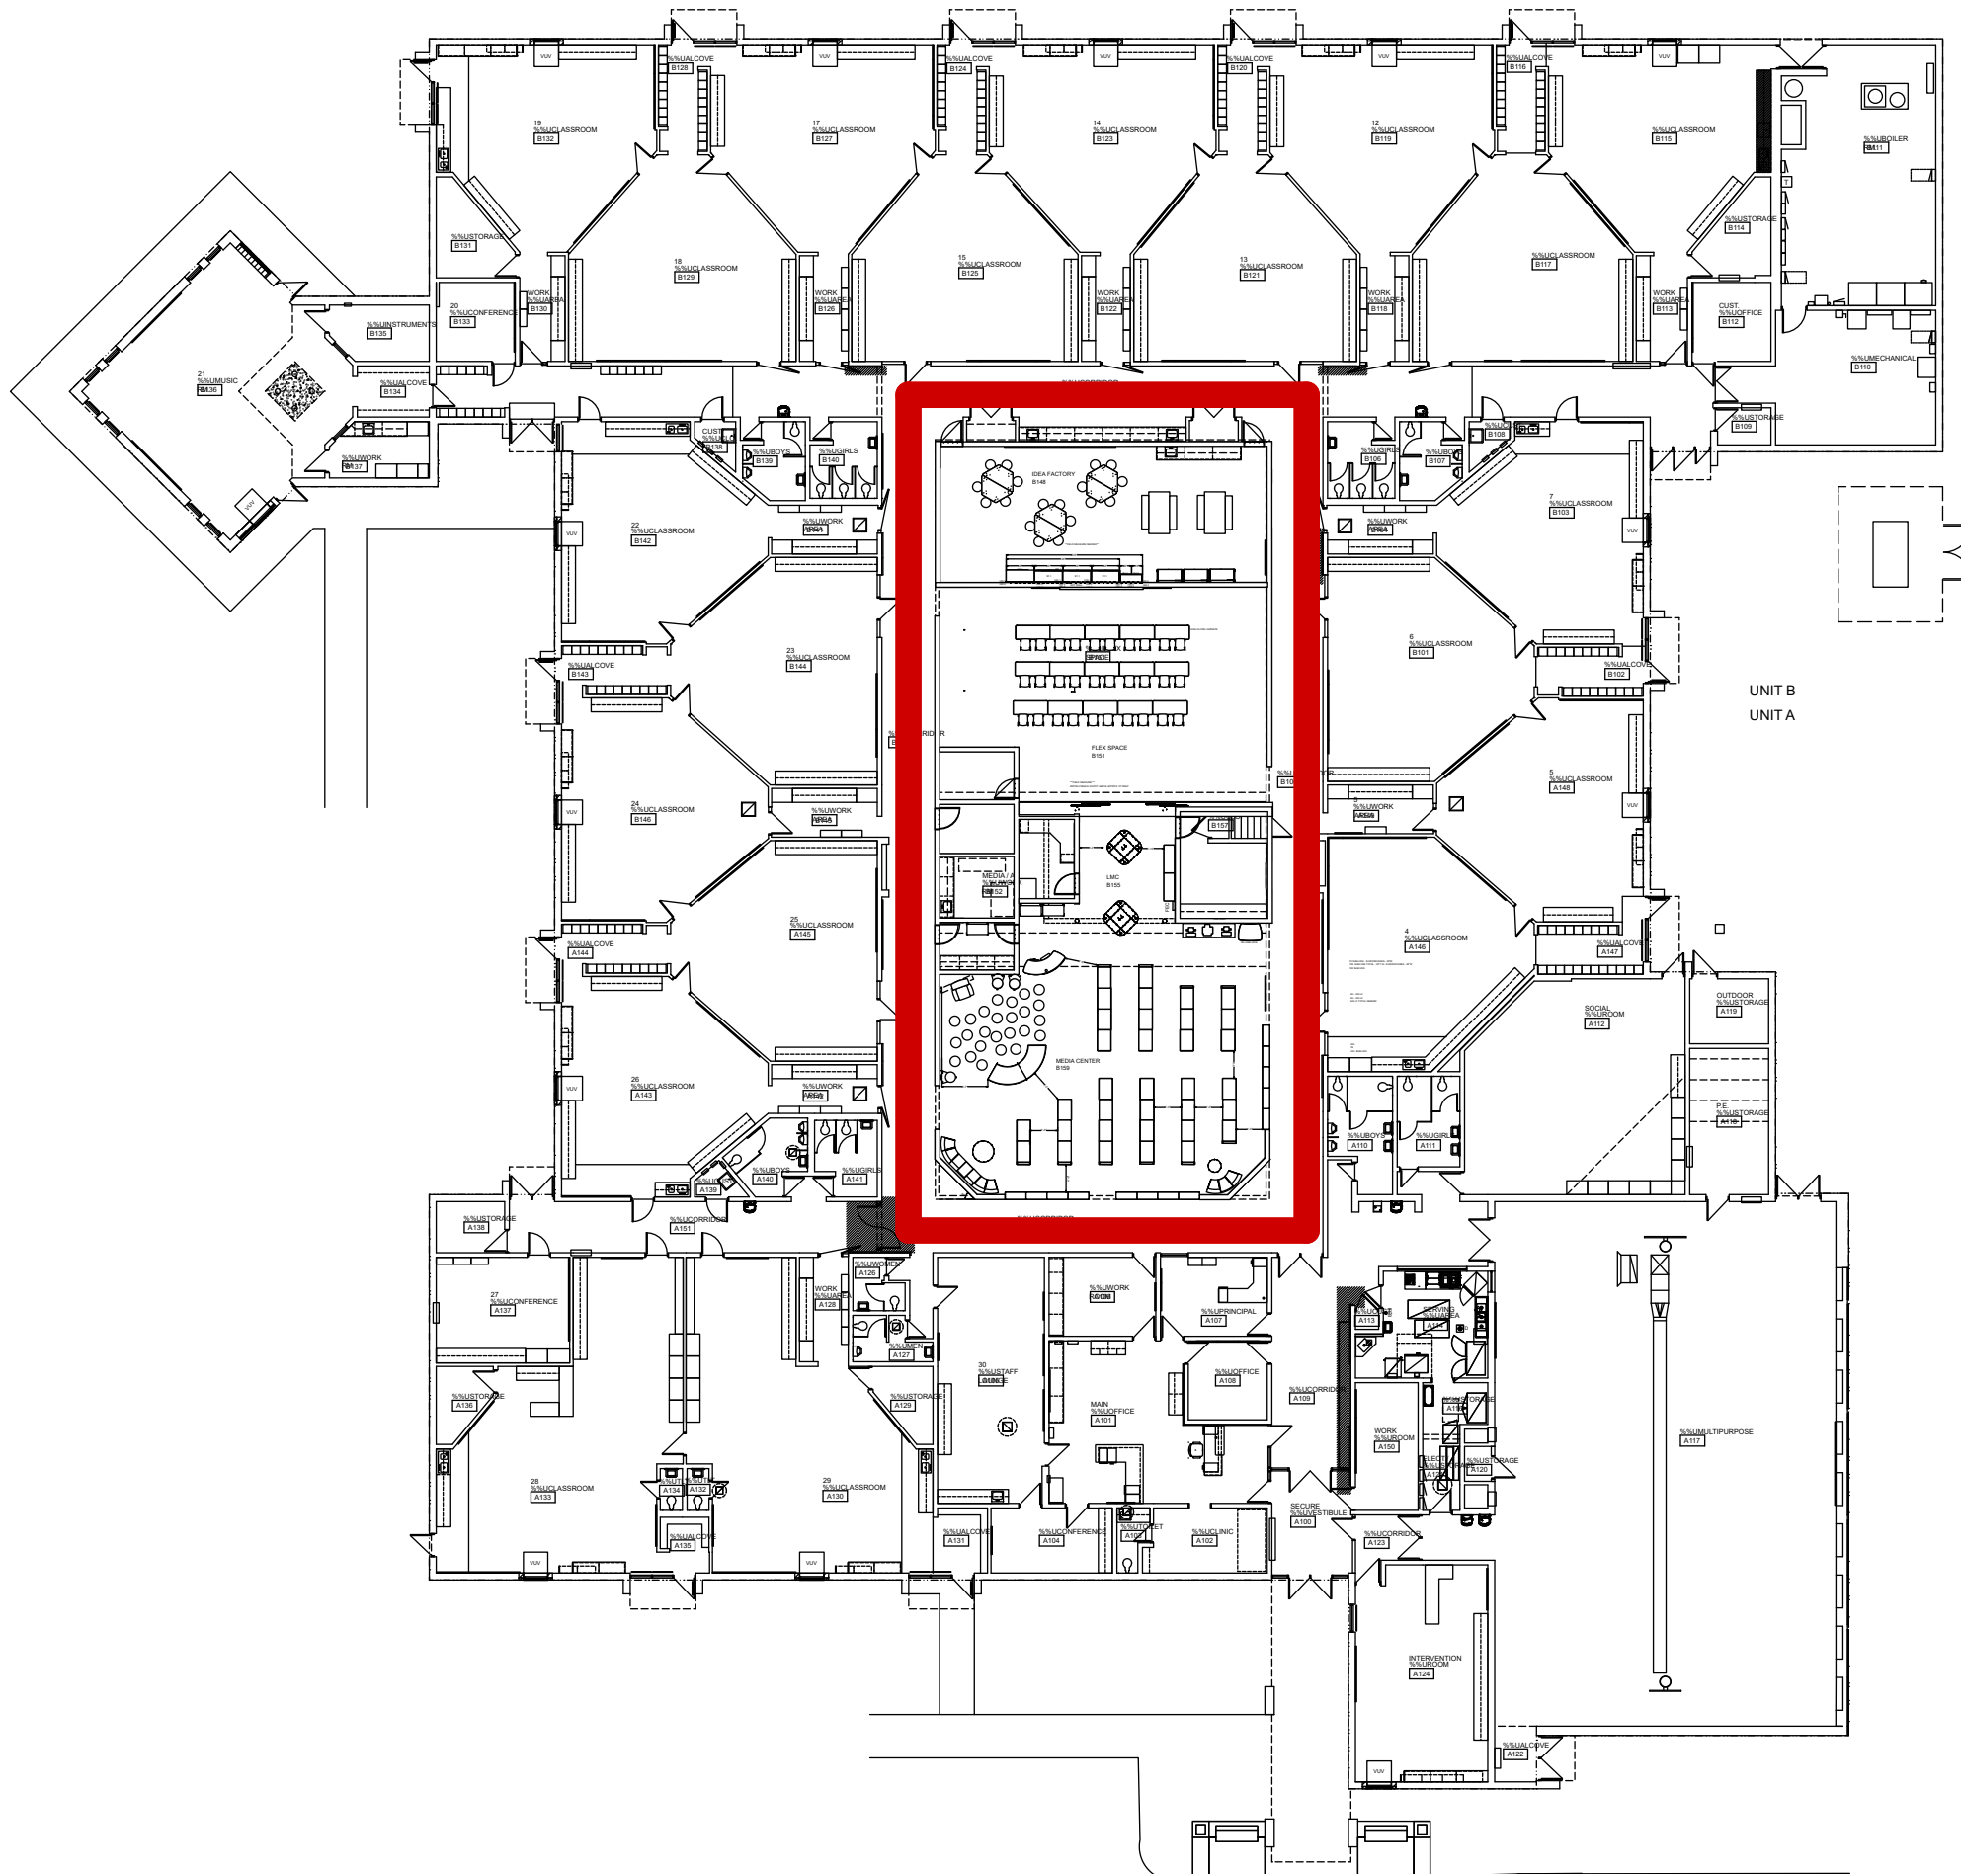

**MEDIA TECH ONLY**  
**MEDIA CENTER + IDEA FACTORY**  
**AUDIT Q#395772**



2595 BELLINGHAM TROY MI 48063  
(248) 823-5400 FAX: (248) 823-5401  
WWW.YOURNBS.COM

NCIDQ SEAL:

GENERAL NOTES:

NOT FOR CONSTRUCTION  
ALL STRUCTURAL, MECHANICAL & ELECTRICAL ENGINEERING IS THE RESPONSIBILITY OF OTHERS.

ALL FURNITURE & DESIGN DRAWINGS ARE IN CONFIDENCE & DISSEMINATION MAY NOT BE MADE WITHOUT PRIOR WRITTEN CONSENT OF NBS. ALL COMMON LAW RIGHTS OF COPYRIGHT AND OTHERWISE ARE HEREBY SPECIFICALLY RESERVED.

FINAL FURNITURE FIT & PLACEMENT IS SUBJECT TO ANY VARIATION FROM THIS PLAN DUE TO CONSTRUCTION CHANGES, FIELD CONDITIONS, MATERIAL DIFFERENCES OR CHANGES REQUIRED FOR ANY REASON WITH NOTIFICATION TO NBS.

IF NBS DID NOT DESIGN THIS PROJECT, NBS DOES NOT ASSUME RESPONSIBILITY FOR THE DESIGN SPECIFICATION OR PARTS OR APPLICATION OF PRODUCTS INCLUDED IN THIS BID. NBS HAS ONLY RESPONDED TO THE PRICING REQUEST FOR THE

APPROVED BY: DATE:

**NBS Project Approval**

Signing off on this document signifies that the Client has reviewed and approves the drawing layout, products/application indicated, and finishes as shown on drawing.

Client Signature

Date

☐ APPROVED

☐ APPROVED AS NOTED

11/18/25

MEDIA TECH AUDIT

OWNER:

**LIVONIA PUBLIC SCHOOLS**

PROJECT:

**NIJI-IRO ELEMENTARY SCHOOL**

36611 CURTIS RD.  
LIVONIA, MI

PROJECT FOLDER:

251692

HEDBERG ORDER #:

TBD

ACCOUNT MANAGER:

M.DUGAN

DESIGNER:

S.MAZZARA

PROJECT MANAGER

F.KREN

DRAWING:

**COMPONENT PLAN**

DRAWING NUMBER:

**ID-3.1B**



2595 Bellingham • Troy, MI 48083 • 248.823.5400  
3201 Pine Tree Rd. Ste. A • Lansing, MI 48911 • 517.886.0072  
5160 Alliance Dr. • Bay City, MI 48706 • 989.895.8574  
4 North St. Clair St. • Toledo, OH 43604 • 419.662.2040



## Quotation 395795

Quote Date 11/24/25

Customer Order FINISHES TBD

Project 251691

Customer L00002

Terms NET 10 DAYS

Account Representative MONIQUE DUGAN

yourNBS.com

Remit Payments to: NBS, 6973 Reliable Parkway, Chicago, IL 60686

### Quote To

Business Office  
Livonia Public Schools  
15125 FARMINGTON RD  
LIVONIA, MI, 48154-5413

### Ship To

HARRY LAU  
WEBSTER ELEMENTARY SCHOOL  
32401 PEMBROKE ST  
1ST FLOOR MEDIA CENTER  
LIVONIA, MI, 48152-1313

Phone +1 (734) 744-2584

ap@livoniapublicschools.org

Phone +1 (734) 744-2537

Cell +1 (734) 812-8597

hlau@livoniapublicschools.org

Sales Location Troy

This quote is valid for 30 days from date of quote.

The following contracts have been utilized for pricing on this quote:

NCPA CONTRACT

PO required to place order. Please reference NBS quote number on your PO.

Quote includes non-union straight time labor for NBS to receive, deliver and install; any owner requested changes requiring additional delivery trip(s) will result in additional charges to be quoted separately.

30-days of free storage is included in our pricing

Pricing does not include the removal or relocation of existing product

Receipt of PO indicates owner approval of product as specified; upon release of order, no changes, cancellations or returns can be made.

Lead time: 14-16 weeks from receipt of PO

\*\*\*Please note: pricing is valid until December 30th at noon -- Media Tech is having a price increase on January 1st\*\*\*

\*\*\*BUDGETARY PRICING ONLY UNTIL FINAL FINISH SELECTIONS ARE MADE\*\*\*

Description	Quantity	Unit Price	Extended Price
-------------	----------	------------	----------------

### CIRC DESK

1	<b>ND-75DXL-MOB</b> - Nomad Desk without transaction ledge 75"W x 29"H Worksurface: Pionite White Fiesta MW550-SD (Premium) Panel B & C: Formica Greyed Oak 5791-PG Panel A: TBD PVC Edge: Silver Gray C600244	1	4,082.19	4,082.19
---	--	---	----------	----------

TITLE OF PRODUCT TRANSFERS UPON RECEIPT BY CUSTOMER.

ACCEPTED BY \_\_\_\_\_ TITLE \_\_\_\_\_ DATE \_\_\_\_\_

**yourNBS.com**

**Remit Payments to:** NBS, 6973 Reliable Parkway, Chicago, IL 60686

Description		Quantity	Unit Price	Extended Price
1	Powdercoat: Silver 809 MEDIA TECH <b>Tag For</b> CIRC DESK ND-75DXL-MOB			
2	<b>ND-40BR-NS-MOB</b> - Nomad mobile book return cabinet Worksurface HPL: Pionite White Fiesta MW550-SD (Premium) Panel B & C: Formica Greyed Oak 5791-PG PVC Edge: Silver Gray C600244 Powdercoate: 809 Silver +/SPECIAL solid top - no slot MEDIA TECH <b>Tag For</b> CIRC DESK ND-40BR-MOB	1	1,974.70	1,974.70
3	<b>MCD-DBTL-1824-24</b> - Depressible book truck 32"/39"H curved units 18" x 24" x 24"H HPL Case: Formica Greyed Oak 5791-PG PVC Edge: Silver Gray C600244 Powdercoat: Silver 809 MEDIA TECH <b>Tag For</b> CIRC DESK MCD-DBTL-1824-24	1	1,490.58	1,490.58
4	<b>WMPS661220-W-LL-PA</b> - Mobile Pedestal 2 box, 1 File Drawer 14-13/16"W x 20-3/4"D x 27"H HPL box: Formica Greyed Oak 5791-PG HPL front: Formica Greyed Oak 5791-PG PVC: Silver Gray C600244 Pulls: P2 Nickel Lock Finish: Nickel MEDIA TECH <b>Tag For</b> CIRC DESK WMPS661220-W-LL	1	615.44	615.44
5	<b>MCD1817</b> - Steel Pencil Drawer 18"W x 17"D x 2"H Finish: Black MEDIA TECH <b>Tag For</b> CIRC DESK MCD1817	1	239.61	239.61
<b>Sub Total</b>				8,402.52
<b>Total</b>				<b>8,402.52</b>
<b>BOOK STACKS</b>				
6	<b>DISPL-4724</b> - End Panel Display 4"D X 24"W X 47"H Laminate: Formica Greyed Oak 5791-PG HPL Back Panel: TBD	16	834.96	13,359.36

TITLE OF PRODUCT TRANSFERS UPON RECEIPT BY CUSTOMER.

ACCEPTED BY \_\_\_\_\_ TITLE \_\_\_\_\_ DATE \_\_\_\_\_



Description	Quantity	Unit Price	Extended Price
<b>6</b> PVC Edge: Silver Gray C600244 MEDIA TECH <b>Tag For</b> BOOK STACKS DISPL-4724			
<b>Sub Total</b>			13,359.36
<b>Total</b>			<b>13,359.36</b>
<b>IDEA FACTORY CASEWORK</b>			
<b>7</b> <b>TRN-SB-841813-L</b> - TRANSITION 84X18X13 STARTER UNIT FLOOR TO TOP OF UNIT HEIGHT 78"H X 20"W X 13"D INCLUDES 3-FIXED AND 4-TAB CAM ADJUSTABLE SHELVES HPL END PANELS/TOP/BASE: TBD PVC END PANELS/TOP/BASE: TBD (Non-Standard) HPL ADJ SHELVES: WILSONART MAGNOLIA 5012-60 PVC ADJ SHELVES: CHARTER MAGNOLIA W5012 MEDIA TECH <b>Tag For</b> IDEA FACTORY CASEWORK SH-1	1	588.00	588.00
<b>8</b> <b>TRN-SB-841813A-L</b> - TRANSITION 84X18X13 ADDER UNIT FLOOR TO TOP OF UNIT HEIGHT 78"H X 19"W X 13"D INCLUDES 3-FIXED AND 4-TAB CAM ADJUSTABLE SHELVES HPL END PANELS/TOP/BASE: TBD PVC END PANELS/TOP/BASE: TBD (Non-Standard) HPL ADJ SHELVES: WILSONART MAGNOLIA 5012-60 PVC ADJ SHELVES: CHARTER MAGNOLIA W5012 MEDIA TECH <b>Tag For</b> IDEA FACTORY CASEWORK SH-2	1	460.60	460.60
<b>9</b> <b>WCS-481430-LL-HPA</b> - ELEMENTS CUPBOARD STORAGE WALL UNIT 48"W X 14"D X 30"H WITH 2-ADJUSTABLE SHELVES, 2-DOORS WITH HINGE HPL: TBD PVC: Charter Magnolia W5012 (Non-Standard) HINGE: H3 CONCEALED PULL: P2 NICKEL LOCK: KEY ALIKE MEDIA TECH <b>Tag For</b> IDEA FACTORY CASEWORK ST-1	3	881.51	2,644.53
<b>10</b> <b>BOF-482434-L-CT</b> - OPEN FOLIO UNIT WITH CONTINUOUS TOP 48"W X 24"D X 34"H 22-FIXED SHELVES HPL: TBD PVC: WILSONART MAGNOLIA 5012-60	1	1,122.10	1,122.10

TITLE OF PRODUCT TRANSFERS UPON RECEIPT BY CUSTOMER.

ACCEPTED BY \_\_\_\_\_ TITLE \_\_\_\_\_ DATE \_\_\_\_\_



Description	Quantity	Unit Price	Extended Price
<b>10</b> HPL FOLIO SHELVES: WILSONART MAGNOLIA 5012-60  ***XBOF-482434-L-CT*** Modified to have vertical support divider panel be offset from center creating (1) 12"W and (1) 36"W section. (See MT provided layout) MEDIA TECH <b>Tag For</b> IDEA FACTORY CASEWORK ST-2			
<b>11</b> <b>ECTBL-C-24196</b> - CONTINUOUS TOP ECT WITH 4" BACK SPLASH 196"W X 24"D X 1.25"H HPL: TBD PVC: TBD MEDIA TECH <b>Tag For</b> IDEA FACTORY CASEWORK WS-1	1	635.04	635.04
<b>12</b> <b>WSCSA48-C-T</b> - 48" WIDE VST ASSEMBLY WITH 2-SUPPORT ARMS +/MODIFIED FOR USE WITH 34"H OVERALL WORKSURFACE TFL back board support with PVC edges. (1) Left and (1) Right hand powder coated arms. TFL: Classic White PVC: Rehau Generic White C100033 Powder Coat: Nickel 808 (Group 2) MEDIA TECH <b>Tag For</b> IDEA FACTORY CASEWORK HW-1	2	210.70	421.40
<b>13</b> <b>HT-96</b> - HORIZONTAL MOUNTING TRACK 96" WITH PRE-PUNCHED MOUNT HOULES ON 16" CENTERS. INCLUDES CONCEALMENT MATERIAL. FINISH: ANODIZED ALUMINUM WALL TYPE: CMU MEDIA TECH <b>Tag For</b> IDEA FACTORY CASEWORK HW-2	5	102.41	512.05
<b>14</b> <b>HTAEC</b> - HORIZONTAL MOUNTING TRACK END CAP WITH MOUNTING SCREWS FINISH: BLACK MEDIA TECH <b>Tag For</b> IDEA FACTORY CASEWORK HW-3	4	8.82	35.28
<b>15</b> <b>HTACS</b> - HORIZONTAL MOUNTING TRACK CONNECTOR SPLICE PLATE FINISH: ALUMINUM MEDIA TECH <b>Tag For</b> IDEA FACTORY CASEWORK HW-4	4	6.86	27.44

TITLE OF PRODUCT TRANSFERS UPON RECEIPT BY CUSTOMER.

ACCEPTED BY \_\_\_\_\_ TITLE \_\_\_\_\_ DATE \_\_\_\_\_

**yourNBS.com**

**Remit Payments to:** NBS, 6973 Reliable Parkway, Chicago, IL 60686

Description		Quantity	Unit Price	Extended Price
<b>Sub Total</b>				6,446.44
<b>Total</b>				<b>6,446.44</b>
<b>16</b>	<b>LOT - UPCHARGE FOR PREMIUM LAMINATE</b> PIONITE WHITE FIESTA MW550-SD FORMICA GRAYED OAK 5791-PG  BUDGETARY AMOUNT UNTIL FINAL SELECTIONS ARE MADE MEDIA TECH	1	1,654.75	1,654.75
<b>17</b>	<b>LOT - UPCHARGE FOR NON-STANDARD PVC</b> CHARTER MAGNOLIA W5012  BUDGETARY AMOUNT UNTIL FINAL SELECTIONS ARE MADE MEDIA TECH	1	446.39	446.39
<b>18</b>	<b>LOT - SET UP FEE FOR GROUP 2 POWDER COAT</b> 808 NICKEL  BUDGETARY AMOUNT UNTIL FINAL SELECTIONS ARE MADE MEDIA TECH	1	170.03	170.03
<b>20</b>	<b>LOT - NON UNION STRAIGHT TIME LABOR TO RECEIVE, DELIVER</b> <b>AND INSTALL NEW MEDIA TECH PRODUCT PER PRINT.</b>  ALL WORK TO BE DONE AT ONE TIME.  PRICING DOES NOT INCLUDE THE REMOVAL OR RELOCATION OF EXISTING PRODUCT. ROSE MOVIN	1	4,393.00	4,393.00
<b>21</b>	<b>LOT - SPLIT SHIP FEE</b> USE ONLY IF NECESSARY ROSE MOVIN	1	322.00	322.00
<b>22</b>	<b>LOT - OVERTIME DIFFERENTIAL FEE</b> USE ONLY IF NECESSARY ROSE MOVIN	1	1,305.00	1,305.00
<b>23</b>	<b>MONTHLY - MONTHLY STORAGE FEE</b> USE ONLY IF NECESSARY  4 MONTHS OF STORAGE HAS BEEN QUOTED ROSE MOVIN	4	418.00	1,672.00
<b>Quotation Totals</b>				
<b>Sub Total</b>				38,171.49
<b>MEDIA TECH FREIGHT</b>				1,322.00
<b>Grand Total</b>				<b>39,493.49</b>

**End of Quotation**

TITLE OF PRODUCT TRANSFERS UPON RECEIPT BY CUSTOMER.

ACCEPTED BY \_\_\_\_\_ TITLE \_\_\_\_\_ DATE \_\_\_\_\_

Quote To

Business Office  
Livonia Public Schools  
15125 FARMINGTON RD  
LIVONIA, MI, 48154-5413

Ship To

HARRY LAU  
NIJI IRO JAPANESE ELEMENTARY SCHOOL  
36611 CURTIS RD  
1ST FL MEDIA CENTER  
LIVONIA, MI, 48152-2755

Phone +1 (734) 744-2584

ap@livoniapublicschools.org

Phone +1 (734) 744-2537

Cell +1 (734) 812-8597

hlau@livoniapublicschools.org

Sales Location Troy

This quote is valid for 30 days from date of quote.

The following contracts have been utilized for pricing on this quote:  
NCPA CONTRACT

PO required to place order. Please reference NBS quote number on your PO.

Quote includes non-union straight time labor for NBS to receive, deliver and install; any owner requested changes requiring additional delivery trip(s) will result in additional charges to be quoted separately.

30-days of free storage is included in our pricing

Pricing does not include the removal or relocation of existing product

Receipt of PO indicates owner approval of product as specified; upon release of order, no changes, cancellations or returns can be made.

Lead time: 14-16 weeks from receipt of PO

\*\*\*Please note: pricing is valid until December 30th at noon -- Media Tech is having a price increase on January 1st\*\*\*

\*\*\*BUDGETARY PRICING ONLY UNTIL FINAL FINISH SELECTIONS ARE MADE\*\*\*

Description	Quantity	Unit Price	Extended Price
CIRCULATION DESK			
1 ND-75DXL-MOB - Nomad Desk without transaction ledge 75"W x 29"H Worksurface: Pionite White Fiesta MW550-SD (Premium) Panel B & C: Formica Greyed Oak 5791-PG Panel A: TBD PVC Edge: Silver Gray C600244	1	4,082.19	4,082.19

TITLE OF PRODUCT TRANSFERS UPON RECEIPT BY CUSTOMER.

**yourNBS.com**

**Remit Payments to:** NBS, 6973 Reliable Parkway, Chicago, IL 60686

Description	Quantity	Unit Price	Extended Price
<b>1</b> Powdercoat: Silver 809 MEDIA TECH <b>Tag For</b> CIRC DESK ND-75DXL-MOB			
<b>2</b> <b>ND-40BR-NS-MOB</b> - Nomad mobile book return cabinet Worksurface HPL: Pionite White Fiesta MW550-SD (Premium) Panel B & C: Formica Greyed Oak 5791-PG PVC Edge: Silver Gray C600244 Powdercoate: 809 Silver +/SPECIAL solid top - no slot MEDIA TECH <b>Tag For</b> CIRC DESK ND-40BR-MOB	1	1,974.70	1,974.70
<b>3</b> <b>MCD-DBTL-1824-24</b> - Depressible book truck 32"/39"H curved units 18" x 24" x 24"H HPL Case: Formica Greyed Oak 5791-PG PVC Edge: Silver Gray C600244 Powdercoat: Silver 809 MEDIA TECH <b>Tag For</b> CIRC DESK MCD-DBTL-1824-24	1	1,490.58	1,490.58
<b>4</b> <b>WMPS661220-W-LL-PA</b> - Mobile Pedestal 2 box, 1 File Drawer 14-13/16"W x 20-3/4"D x 27"H HPL box: Formica Greyed Oak 5791-PG HPL front: Formica Greyed Oak 5791-PG PVC: Silver Gray C600244 Pulls: P2 Nickel Lock Finish: Nickel MEDIA TECH <b>Tag For</b> CIRC DESK WMPS661220-W-LL	1	615.44	615.44
<b>5</b> <b>MCD1817</b> - Steel Pencil Drawer 18"W x 17"D x 2"H Finish: Black MEDIA TECH <b>Tag For</b> CIRC DESK MCD1817	1	239.61	239.61
<b>Sub Total</b>			<b>8,402.52</b>
<b>Total</b>			<b>8,402.52</b>

## BOOK STACKS

<b>6</b> <b>DISPL-4724</b> - End Panel Display 4"D X 24"W X 47"H Laminate: Formica Greyed Oak 5791-PG	10	834.96	8,349.60
---	----	--------	----------

TITLE OF PRODUCT TRANSFERS UPON RECEIPT BY CUSTOMER.

ACCEPTED BY \_\_\_\_\_ TITLE \_\_\_\_\_ DATE \_\_\_\_\_



**yourNBS.com**

**Remit Payments to:** NBS, 6973 Reliable Parkway, Chicago, IL 60686

Description	Quantity	Unit Price	Extended Price
<b>6</b> HPL Back Panel: TBD PVC Edge: Silver Gray C600244 MEDIA TECH <b>Tag For</b> BOOK STACKS DISPL-4724			
<b>Sub Total</b>			<b>8,349.60</b>
<b>Total</b>			<b>8,349.60</b>
<b>IDEA FACTORY CASEWORK</b>			
<b>7</b> <b>TRN-SB-841813-L</b> - TRANSITION 84X18X13 STARTER UNIT FLOOR TO TOP OF UNIT HEIGHT 78"H X 20"W X 13"D INCLUDES 3-FIXED AND 4-TAB CAM ADJUSTABLE SHELVES HPL END PANELS/TOP/BASE: TBD PVC END PANELS/TOP/BASE: TBD (Non-Standard) HPL ADJ SHELVES: WILSONART MAGNOLIA 5012-60 PVC ADJ SHELVES: CHARTER MAGNOLIA W5012 MEDIA TECH <b>Tag For</b> IDEA FACTORY CASEWORK SH-1	1	588.00	588.00
<b>8</b> <b>TRN-SB-841813A-L</b> - TRANSITION 84X18X13 ADDER UNIT FLOOR TO TOP OF UNIT HEIGHT 78"H X 19"W X 13"D INCLUDES 3-FIXED AND 4-TAB CAM ADJUSTABLE SHELVES HPL END PANELS/TOP/BASE: TBD PVC END PANELS/TOP/BASE: TBD (Non-Standard) HPL ADJ SHELVES: WILSONART MAGNOLIA 5012-60 PVC ADJ SHELVES: CHARTER MAGNOLIA W5012 MEDIA TECH <b>Tag For</b> IDEA FACTORY CASEWORK SH-2	1	460.60	460.60
<b>9</b> <b>WCS-481430-LL-HPA</b> - ELEMENTS CUPBOARD STORAGE WALL UNIT 48"W X 14"D X 30"H WITH 2-ADJUSTABLE SHELVES, 2-DOORS WITH HINGE HPL: TBD PVC: Charter Magnolia W5012 (Non-Standard) HINGE: H3 CONCEALED PULL: P2 NICKEL LOCK: KEY ALIKE MEDIA TECH <b>Tag For</b> IDEA FACTORY CASEWORK ST-1	3	881.51	2,644.53
<b>10</b> <b>BOF-482434-L-CT</b> - OPEN FOLIO UNIT WITH CONTINUOUS TOP 48"W X 24"D X 34"H 22-FIXED SHELVES HPL: TBD	1	1,122.10	1,122.10

TITLE OF PRODUCT TRANSFERS UPON RECEIPT BY CUSTOMER.

ACCEPTED BY \_\_\_\_\_ TITLE \_\_\_\_\_ DATE \_\_\_\_\_

yourNBS.com

Remit Payments to: NBS, 6973 Reliable Parkway, Chicago, IL 60686

Description	Quantity	Unit Price	Extended Price
<b>10</b> PVC: WILSONART MAGNOLIA 5012-60 HPL FOLIO SHELVES: WILSONART MAGNOLIA 5012-60  ***XBOF-482434-L-CT*** Modified to have vertical support divider panel be offset from center creating (1) 12"W and (1) 36"W section. (See MT provided layout) MEDIA TECH <b>Tag For</b> IDEA FACTORY CASEWORK ST-2			
<b>11</b> <b>ECTBL-C-24196</b> - CONTINUOUS TOP ECT WITH 4" BACK SPLASH 196"W X 24"D X 1.25"H HPL: TBD PVC: TBD MEDIA TECH <b>Tag For</b> IDEA FACTORY CASEWORK WS-1	1	635.04	635.04
<b>12</b> <b>WSCSA48-C-T</b> - 48" WIDE VST ASSEMBLY WITH 2-SUPPORT ARMS +/-MODIFIED FOR USE WITH 34"H OVERALL WORKSURFACE TFL back board support with PVC edges. (1) Left and (1) Right hand powder coated arms. TFL: Classic White PVC: Rehau Generic White C100033 Powder Coat: Nickel 808 (Group 2) MEDIA TECH <b>Tag For</b> IDEA FACTORY CASEWORK HW-1	2	210.70	421.40
<b>13</b> <b>HT-96</b> - HORIZONTAL MOUNTING TRACK 96" WITH PRE-PUNCHED MOUNT HOULES ON 16" CENTERS. INCLUDES CONCEALMENT MATERIAL. FINISH: ANODIZED ALUMINUM WALL TYPE: CMU MEDIA TECH <b>Tag For</b> IDEA FACTORY CASEWORK HW-2	5	102.41	512.05
<b>14</b> <b>HTAEC</b> - HORIZONTAL MOUNTING TRACK END CAP WITH MOUNTING SCREWS FINISH: BLACK MEDIA TECH <b>Tag For</b> IDEA FACTORY CASEWORK HW-3	4	8.82	35.28
<b>15</b> <b>HTACS</b> - HORIZONTAL MOUNTING TRACK CONNECTOR SPLICE PLATE FINISH: ALUMINUM MEDIA TECH <b>Tag For</b> IDEA FACTORY CASEWORK HW-4	4	6.86	27.44

TITLE OF PRODUCT TRANSFERS UPON RECEIPT BY CUSTOMER.

ACCEPTED BY \_\_\_\_\_ TITLE \_\_\_\_\_ DATE \_\_\_\_\_

**yourNBS.com**

**Remit Payments to:** NBS, 6973 Reliable Parkway, Chicago, IL 60686

Description		Quantity	Unit Price	Extended Price
<b>Sub Total</b>				<b>6,446.44</b>
<b>Total</b>				<b>6,446.44</b>
<b>16</b>	<b>LOT - UPCHARGE FOR PREMIUM LAMINATE</b> PIONITE WHITE FIESTA MW550-SD FORMICA GRAYED OAK 5791-PG  BUDGETARY AMOUNT UNTIL FINAL SELECTIONS ARE MADE MEDIA TECH	1	1,354.16	1,354.16
<b>17</b>	<b>LOT - UPCHARGE FOR NON-STANDARD PVC</b> CHARTER MAGNOLIA W5012  BUDGETARY AMOUNT UNTIL FINAL SELECTIONS ARE MADE MEDIA TECH	1	446.39	446.39
<b>18</b>	<b>LOT - SET UP FEE FOR GROUP 2 POWDER COAT</b> 808 NICKEL  BUDGETARY AMOUNT UNTIL FINAL SELECTIONS ARE MADE MEDIA TECH	1	170.03	170.03
<b>20</b>	<b>LOT - NON UNION STRAIGHT TIME LABOR TO RECEIVE, DELIVER</b> <b>AND INSTALL NEW MEDIA TECH PRODUCT PER PRINT.</b>  ALL WORK TO BE DONE AT ONE TIME.  PRICING DOES NOT INCLUDE THE REMOVAL OR RELOCATION OF EXISTING PRODUCT. ROSE MOVIN	1	3,509.00	3,509.00
<b>21</b>	<b>LOT - SPLIT SHIP FEE</b> USE ONLY IF NECESSARY ROSE MOVIN	1	322.00	322.00
<b>22</b>	<b>LOT - OVERTIME DIFFERENTIAL FEE</b> USE ONLY IF NECESSARY ROSE MOVIN	1	995.00	995.00
<b>23</b>	<b>MONTHLY - MONTHLY STORAGE FEE</b> USE ONLY IF NECESSARY  4 MONTHS OF STORAGE HAS BEEN QUOTED ROSE MOVIN	4	333.00	1,332.00
<b>Quotation Totals</b>				
<b>Sub Total</b>				<b>31,327.14</b>
<b>MEDIA TECH FREIGHT</b>				<b>1,322.00</b>
<b>Grand Total</b>				<b>32,649.14</b>

**End of Quotation**

TITLE OF PRODUCT TRANSFERS UPON RECEIPT BY CUSTOMER.

ACCEPTED BY \_\_\_\_\_ TITLE \_\_\_\_\_ DATE \_\_\_\_\_