

December 7, 2023

Mr. Phillip Francis
Assistant Superintendent of District Services
Livonia Public Schools
15125 Farmington Road
Livonia, MI 48154

RE: 2021 Bond Program
LMC Bookcase Purchase Recommendation
Hayes ES / Hoover ES / Roosevelt ES / Holmes MS / Stevenson HS

Dear Mr. Francis:

This letter transmits an update from Plante Moran Realpoint (PMR) as it relates to the assignment to assist and advise Livonia Public Schools (LPS) in its purchase of furniture for the Projects listed above. This update represents the mutual efforts of PMR, French Associates, and LPS administration and staff (the Team).

Coinciding with ongoing design efforts to renovate and reimagine LMC spaces as part of the 2021 Bond Program, the Team has conducted multiple meetings and site visits over the course of the past few months focused on the selection of furniture to best serve each space. While decisions around the balance of 2024 LMC sites remain ongoing, the Team is driven to expedite the purchase of bookcases for each site specifically due to current material procurement timelines and efforts to streamline installation of the bookcases upon completion of renovation activities.

The Team recommends awarding **NBS Commercial Interiors** to supply and install LMC bookcases in an amount not-to-exceed **\$377,000.00** as further detailed below and within French's recommendation documents.

Hayes Elementary School	\$49,862.05
Hoover Elementary School	\$70,454.45
Roosevelt Elementary School	\$53,896.60
Holmes Middle School	\$83,417.45
Stevenson High School	\$101,822.95
<hr/>	
NBS Quotation	\$359,453.50
Contingency (5%)	\$17,546.50
<hr/>	
Award Recommendation (NTE)	\$377,000.00

For the Vendor, the pricing for this work will be detailed in a Purchase Order Agreement, pending final review and approval of terms by district legal counsel.

The Team is available at the Board's convenience to answer any questions regarding this recommendation. Please direct all questions through me via email at brian.weber@plantemoran.com.

Sincerely,

PLANTE MORAN REALPOINT



Brian Weber
Senior Vice President

Enclosures: French Associates Recommendation Letter
Product Information & Layout
Vendor Proposals



architects planners interiors

236 Mill Street
Rochester, MI
48307

December 4th, 2023

Phillip Francis
Asst. Superintendent of District Services
Livonia Public Schools

**Subject: 2021 Bond Program – 2024 Renovations
Media Center Bookcases**

Dear Mr. Francis,

French Associates has been consulting with NBS Commercial Interiors in the development and programming of furniture for the 2021 Bond Program projects. Throughout the design process, NBS has aided in product selections, availability, and lead times.

On November 29th, 2023, French Associates received furniture quotes from NBS Commercial Interiors for the Media Center bookcases for Hayes Elementary, Hoover Elementary, Roosevelt Elementary, Holmes Middle School, and Stevenson High School. The bookcases are to be ordered early to ensure on time manufacturing and stored at Media Technologies free of charge until summer of 2024 installation.

Enclosed are the furniture quotes that utilize the NCPA consortium group pricing. The totals for these projects are as follows:

Hayes Elementary: \$49,862.05
Hoover Elementary: \$70,454.45
Roosevelt Elementary: \$53,896.60
Holmes Middle School: \$83,417.45
Stevenson High School: \$101,822.95

French Associates is recommending award to NBS Commercial Interiors for the procurement and installation of furniture bookcases in the Media Centers at all the schools listed above.


Please contact me if you have any questions.

Sincerely,


Jessica Walter
Interior Designer



OVERALL RENDERING

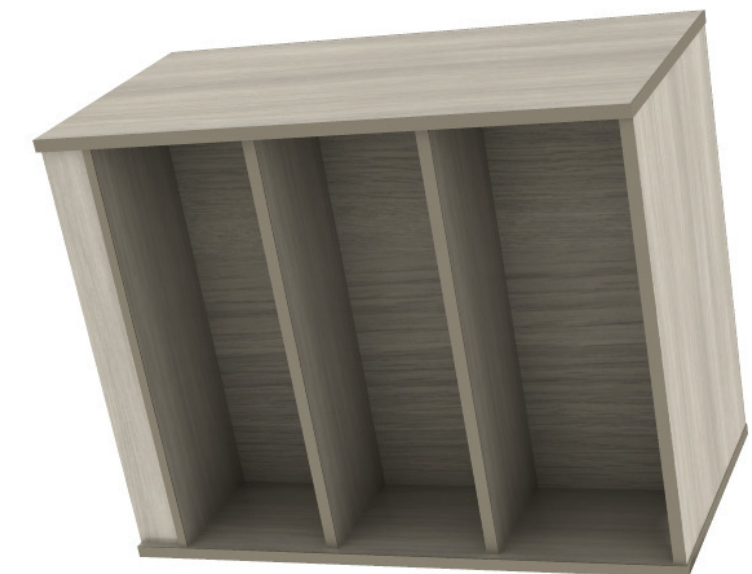

MEDIA TECHNOLOGIES -
BENCHMARK 11 SERIES
MOBILE DOUBLE-FACED
36"W X 24"D X 48"H
BOOKSHELF

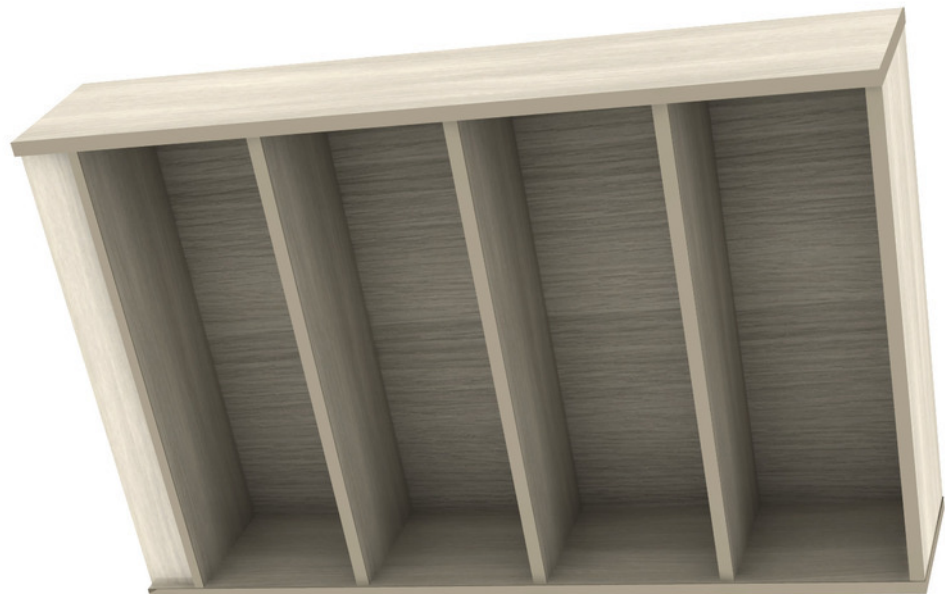

MEDIA TECHNOLOGIES -
BENCHMARK 11 SERIES
SINGLE-FACED
36"W X 12"D X 60"H
BOOKSHELF



PANEL HPL:
PREMIUM HPL:
GREYED OAK 5791



WORKSURFACE:
NEVAMAR WHITE
FIESTA MW550



ACCENT PANEL:
WILSONART CATALINA
13092



PVC EDGE: SILVER GRAY
C600244
POWDER COAT: SILVER 809




BOOKSHELF
PREMIUM HPL:
GREYED OAK 5791




DISPLAY BACK PANEL:
HPL: WILSONART
CANDY APPLE 13096-30

FINISHES

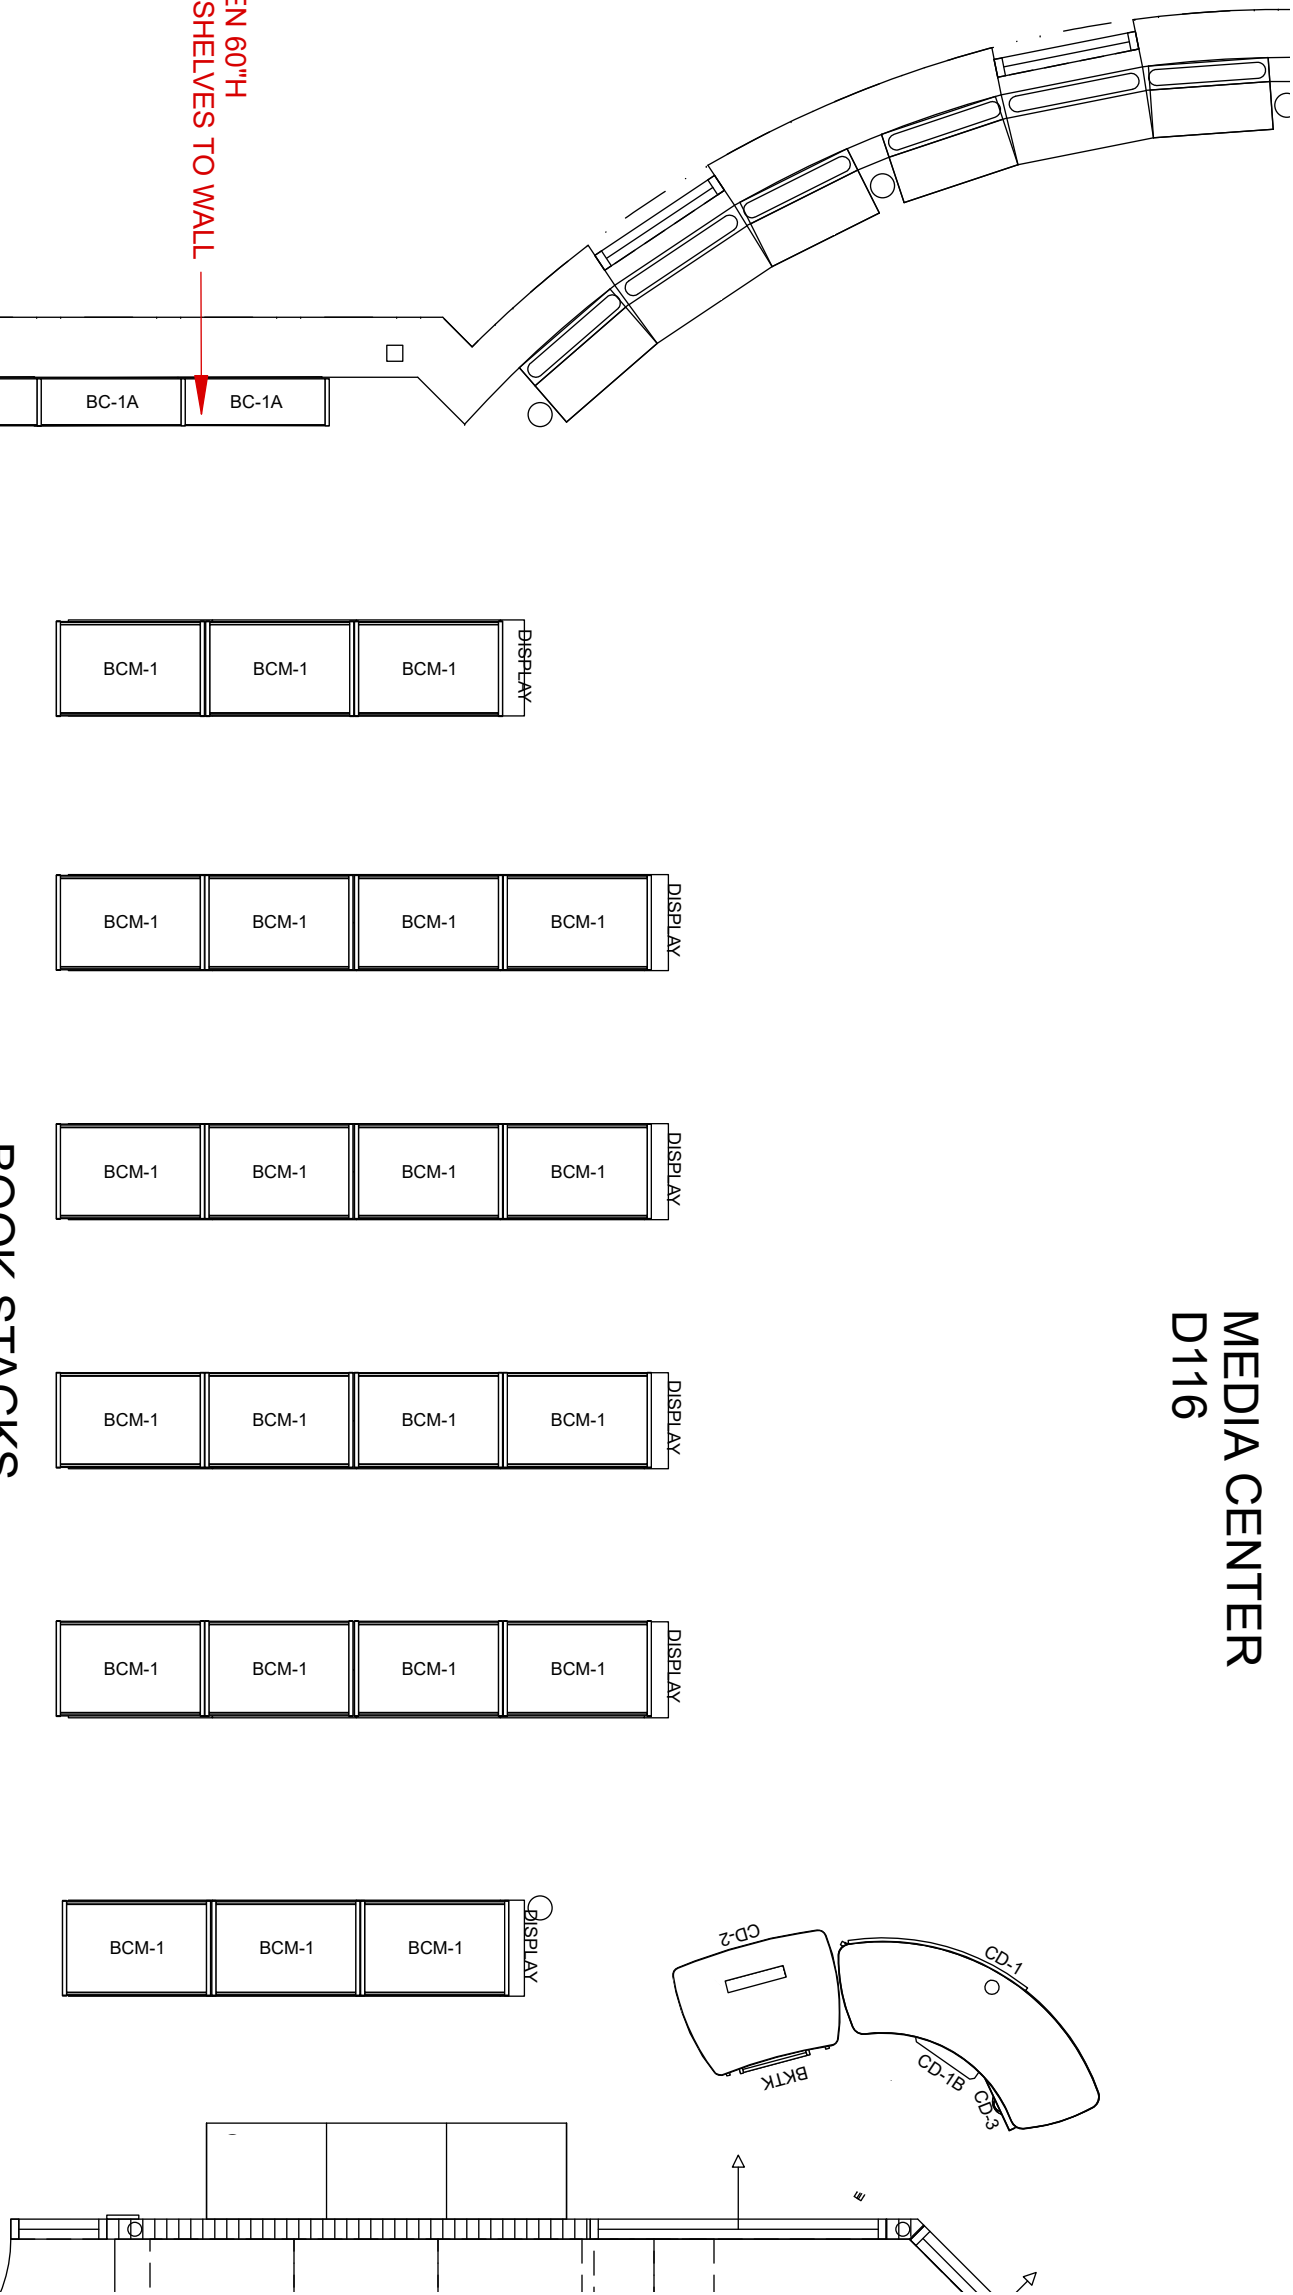

COMPONENT PLAN

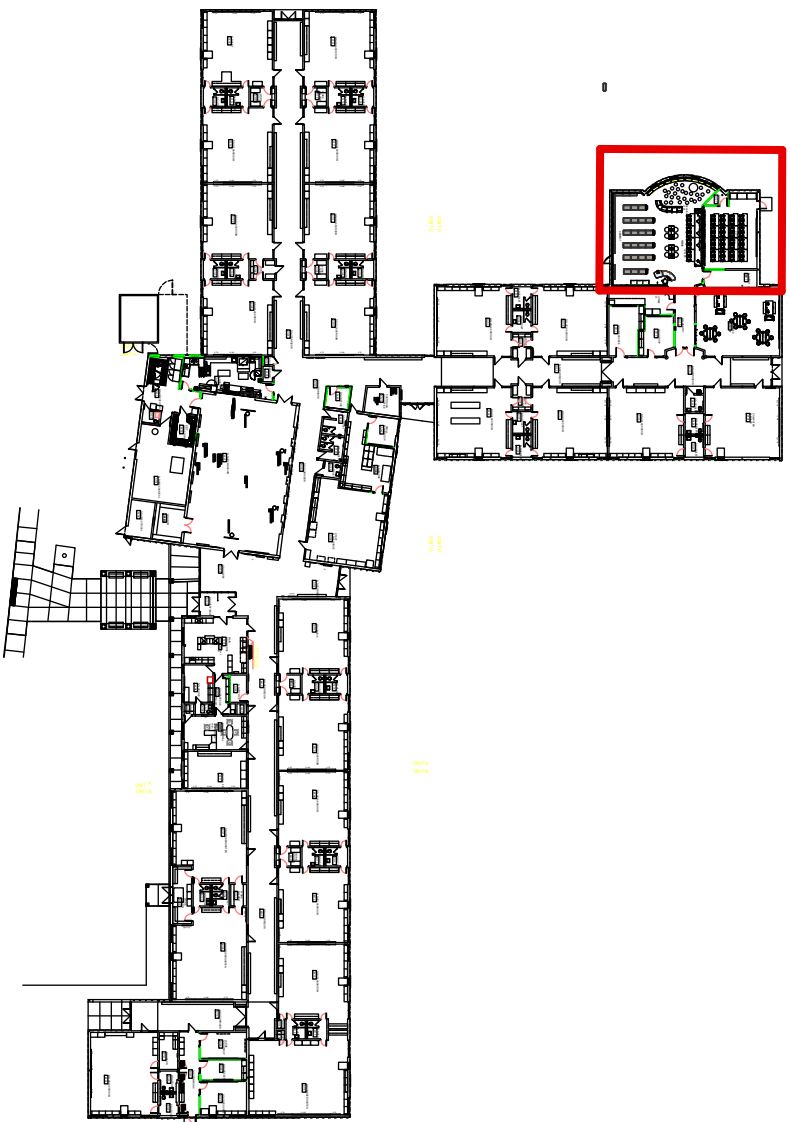

KEY PLAN

MEDIA TECH ONLY
GROUND FLOOR
AUDIT a#369593



2355 BELTINGHAM TROX, MI 48063
(482) 255-4444
WWW.YOURNBS.COM

NBDO SEAL:

GENERAL NOTES:
NOT FOR CONSTRUCTION
ALL STRUCTURAL, MECHANICAL & ELECTRICAL ENGINEERING IS THE RESPONSIBILITY OF THE ARCHITECT.
ALL FINISHING & RENOVATION DRAWINGS ARE IN CONFORMANCE & RESERVATION MAY NOT BE REPRODUCED OR TRANSMITTED IN ANY FORM OR BY ANY MEANS, ELECTRONIC OR MECHANICAL, INCLUDING PHOTOCOPYING, RECORDING, OR BY ANY INFORMATION STORAGE AND RETRIEVAL SYSTEM. ALL RIGHTS OF COPYRIGHT AND OTHERWISE ARE HEREBY SPECIFICALLY RESERVED.
FINAL LAYOUTING: FIT A VENDOR IS SUBJECT TO ANY VARIATION FROM THIS PLAN. CHANGES REQUIRED DURING CONSTRUCTION ARE THE RESPONSIBILITY OF THE ARCHITECT. THIS BID WAS NOT RESPONDED TO THE PROJECT REQUEST FOR THE CLERK IN

APPROVED BY: DATE:

☐ APPROVED ☐ APPROVED AS NOTED

11/28/23 AUDIT MEDIA TECH

OWNER:

LIVONIA PUBLIC
SCHOOLS

PROJECT:
HAYES EL - MEDIA CENTER
RENOVATION

30600 LOUISE CT.
WESTLAND, MI

PROJECT FOLDER: 231577

HEDBERG ORDER #: TBD

ACCOUNT MANAGER: M. DUGAN

DESIGNER: S. MAZZARA


PROJECT MANAGER: M. GREEN

DRAWING:

COMPONENT
PLAN

DRAWING NUMBER:

ID-3.1

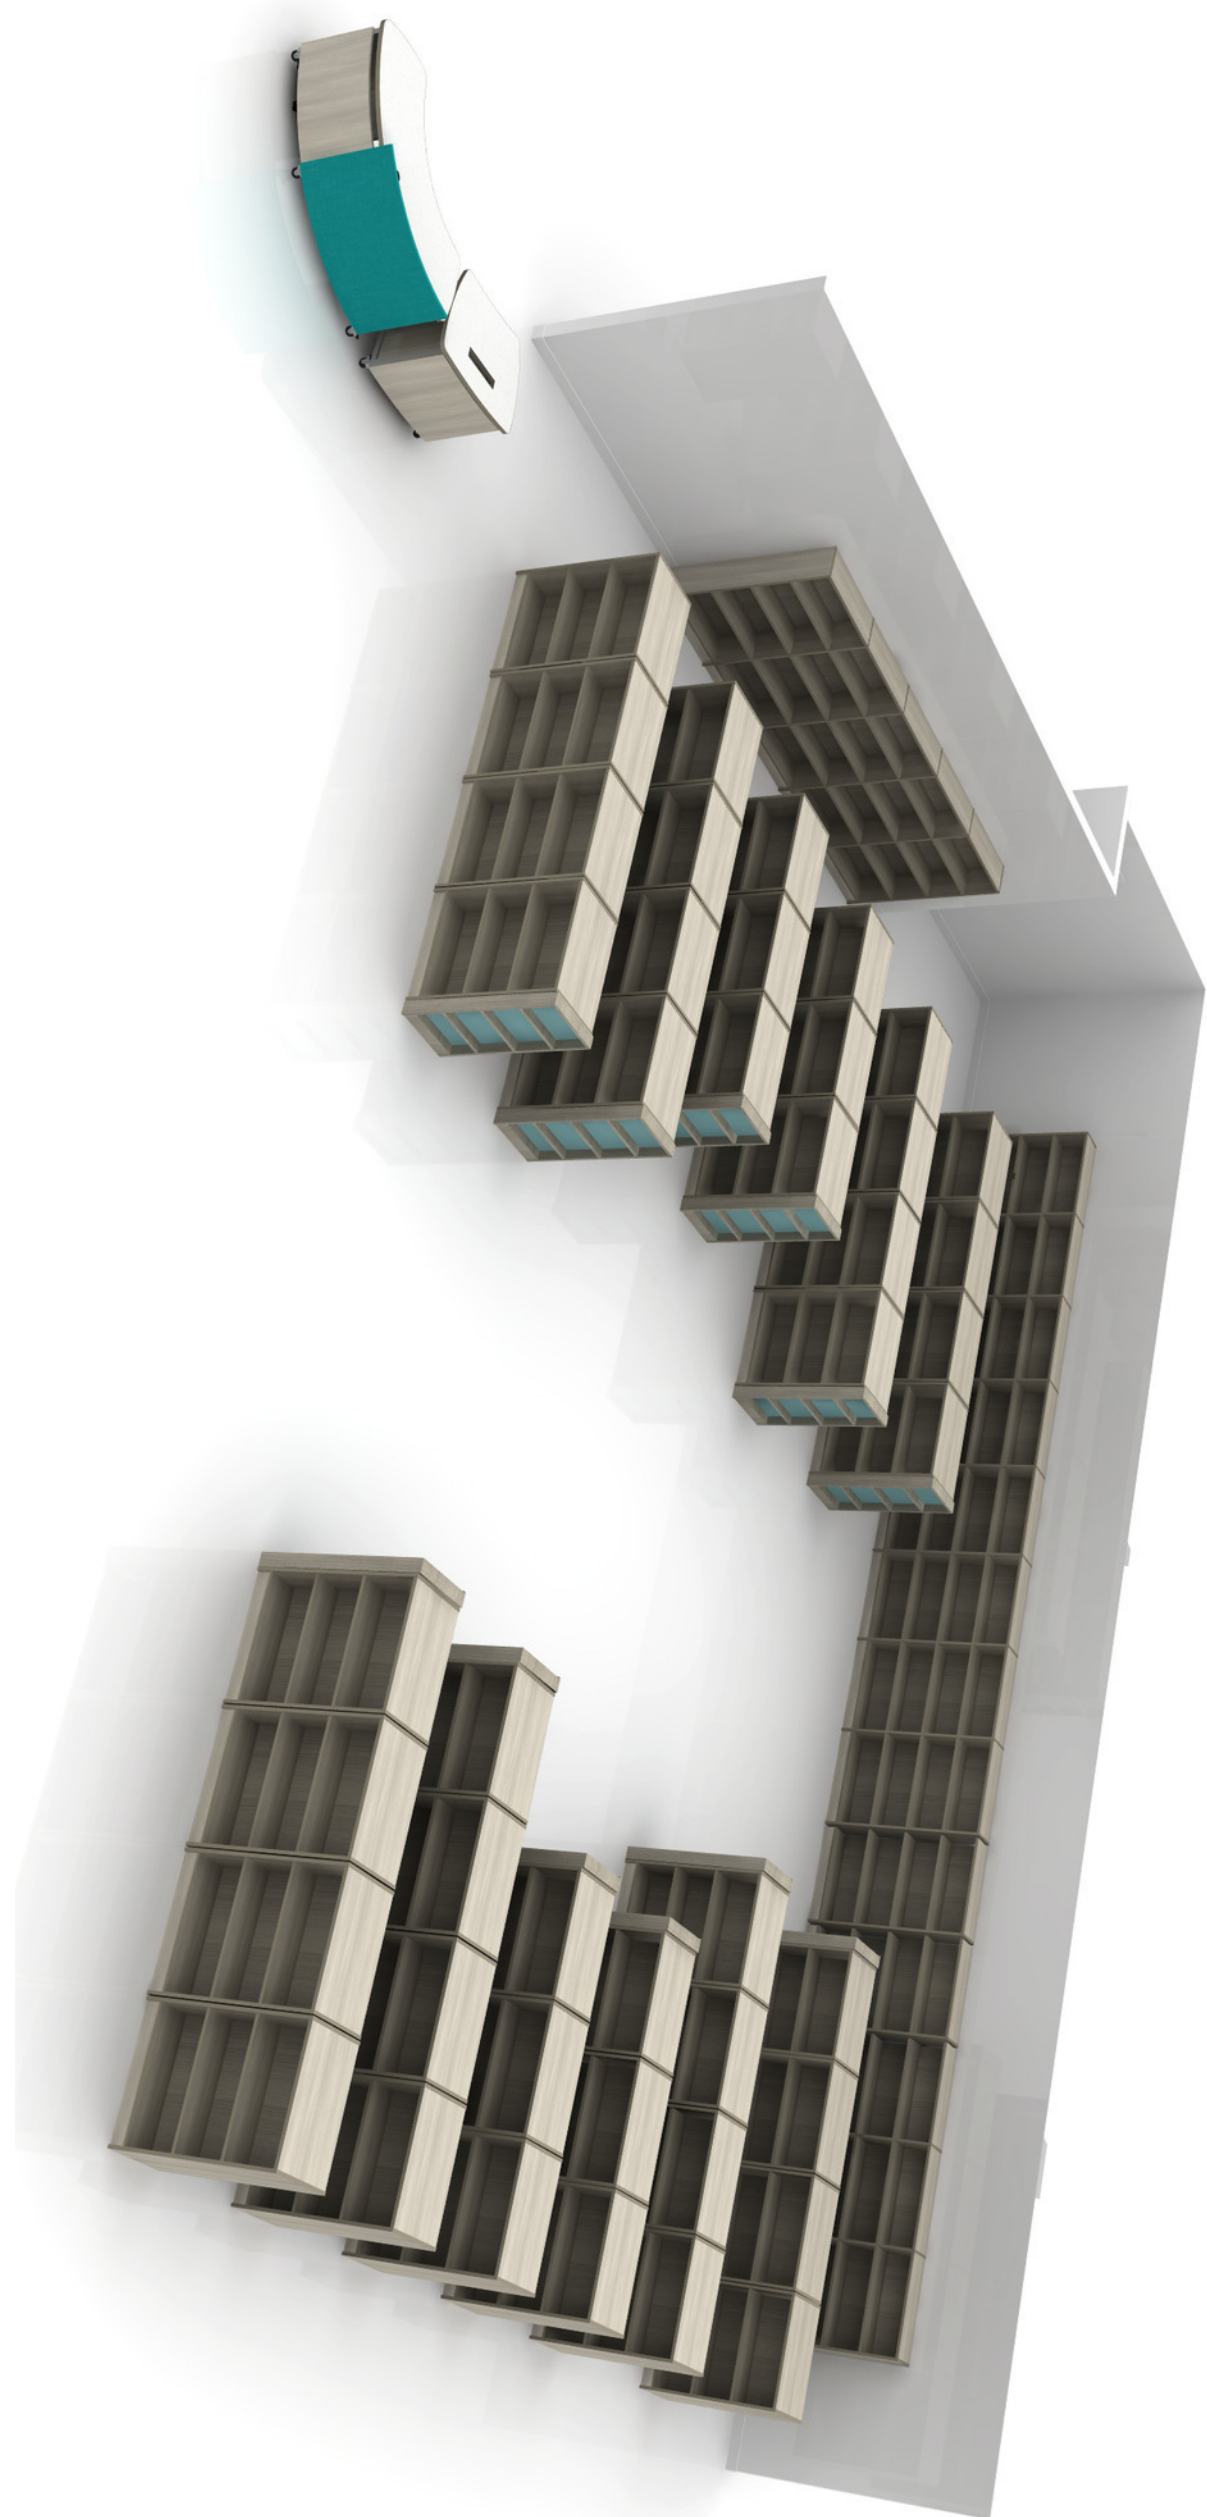

OVERALL RENDERING



PANEL HPL:
PREMIUM HPL:
GREYED OAK 5791


**WORKSURFACE:
NEVAMAR WHITE
FIESTA MW550**




ACCENT PANEL:
WILSONART
MOROCCAN 13094



PVC EDGE: SILVER GRAY
C600244
POWDER COAT: SILVER 809

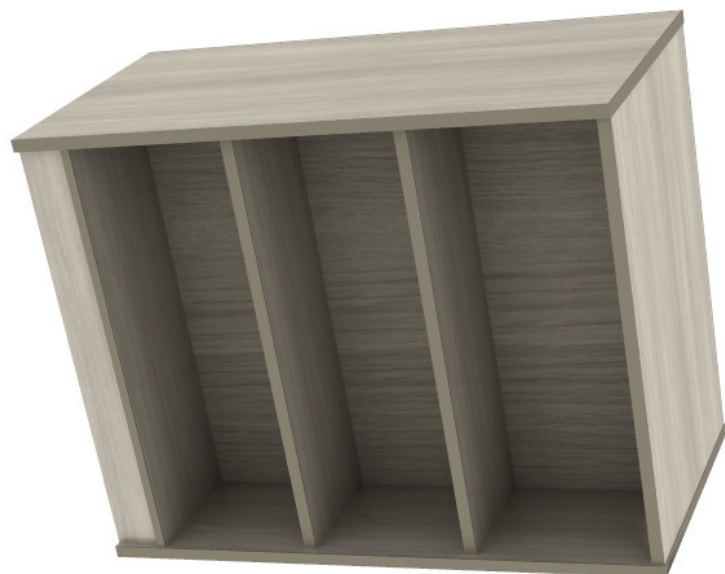


**MEDIA TECHNOLOGIES -
BENCHMARK 11 SERIES
MOBILE DOUBLE-FACED
36"W X 24"D X 48"H
BOOKSHELF**

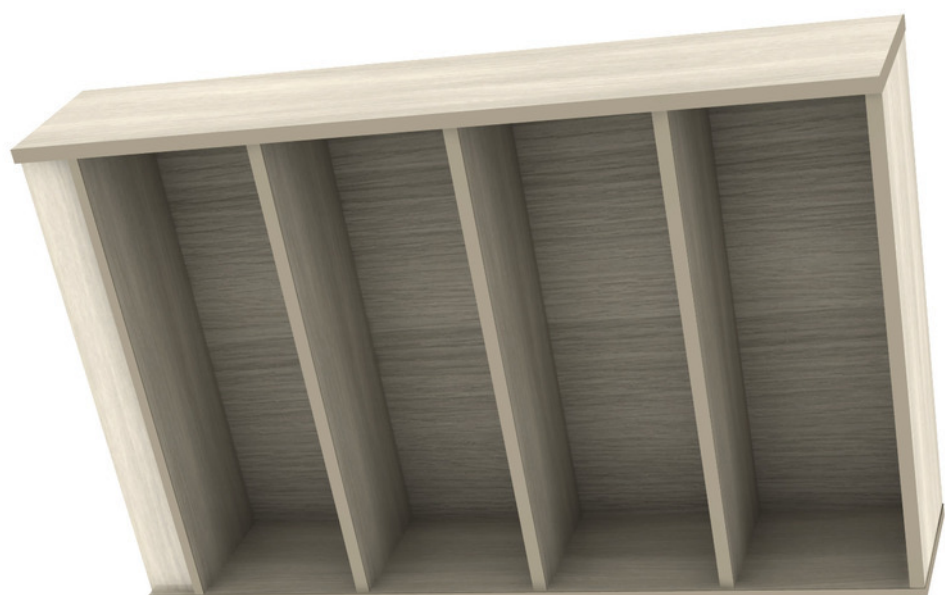

**MEDIA TECHNOLOGIES -
BENCHMARK 11 SERIES
SINGLE-FACED
36"W X 12"D X 60"H
BOOKSHELF**







PVC EDGE: SILVER GRAY C600244

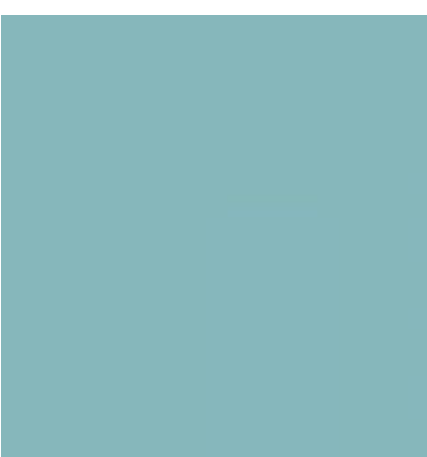


**BOOKSHELF
PREMIUM HPL:
GREYED OAK 5791**

DISPLAY BACK PANEL
HPL: PIONITE SV713
SURFIN USA

BOOKSHELF FINISHES

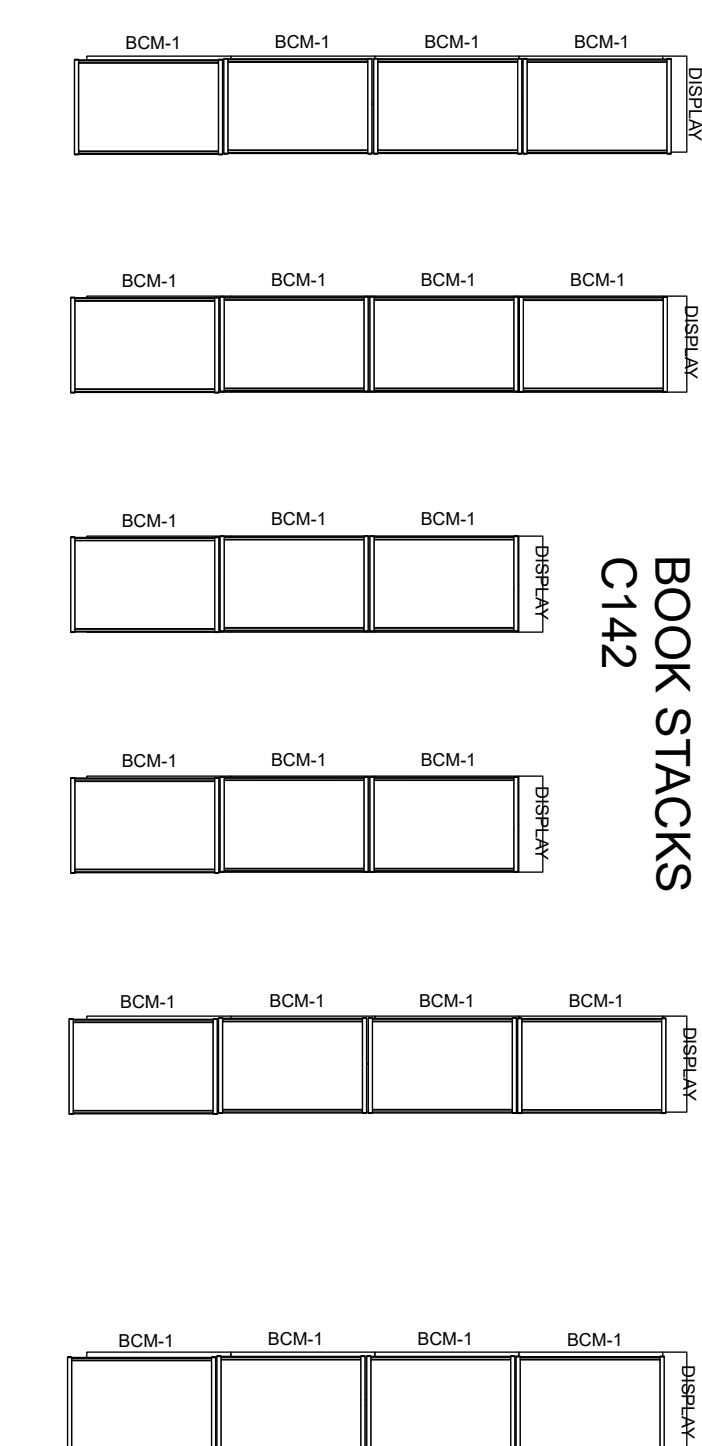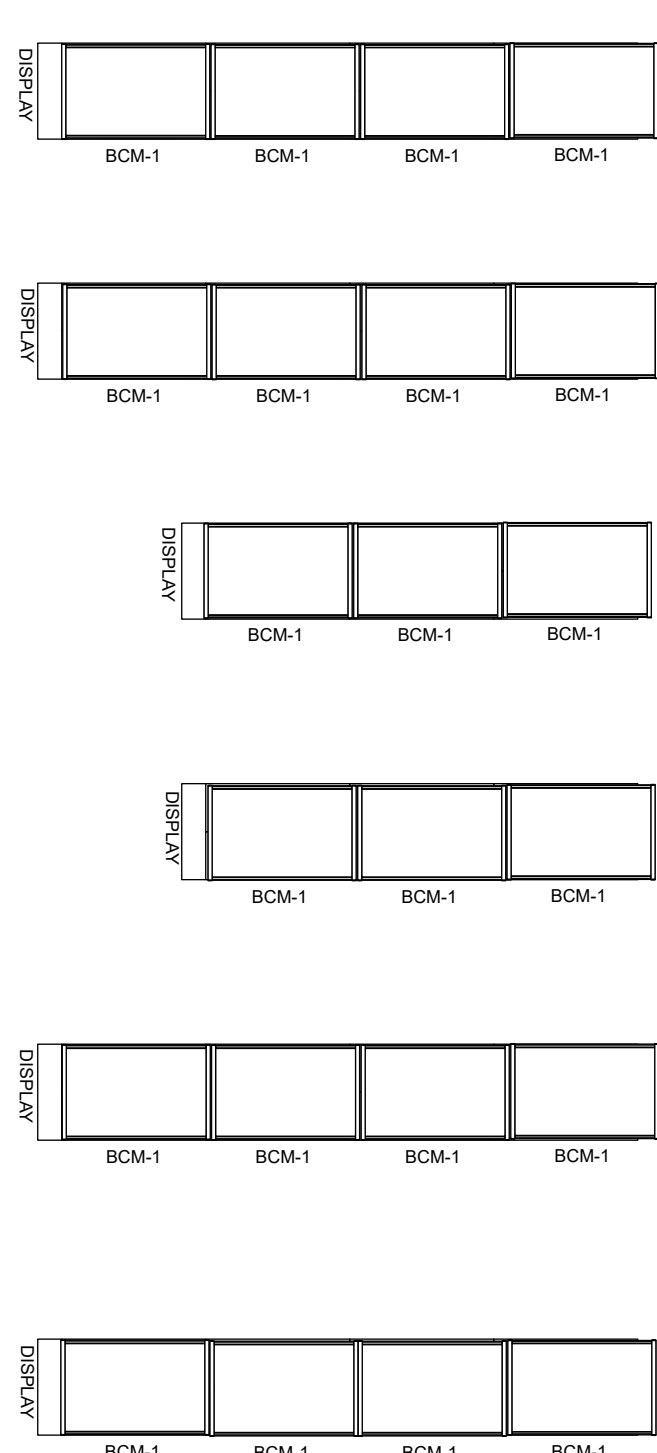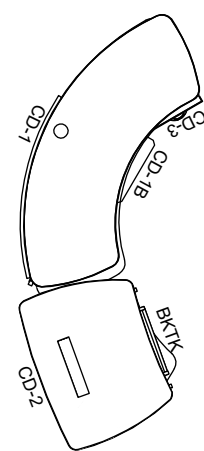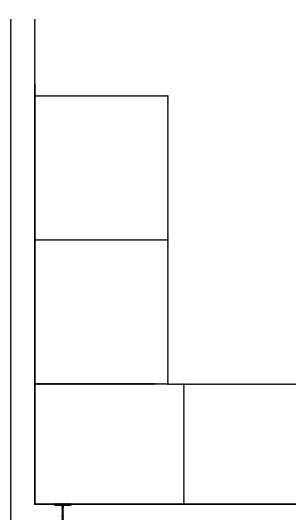
BOOK STACKS
C142

C142

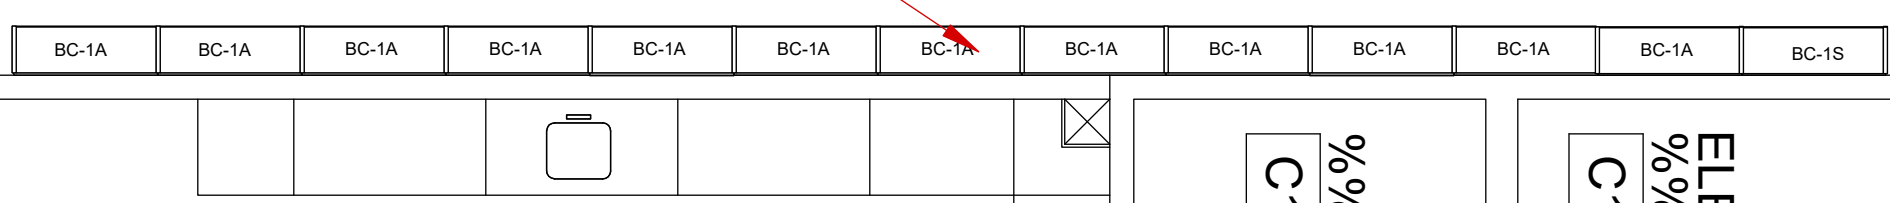

FASTEN 60"H
BOOKSHELVES
TO WALL —

COMPONENT PLAN

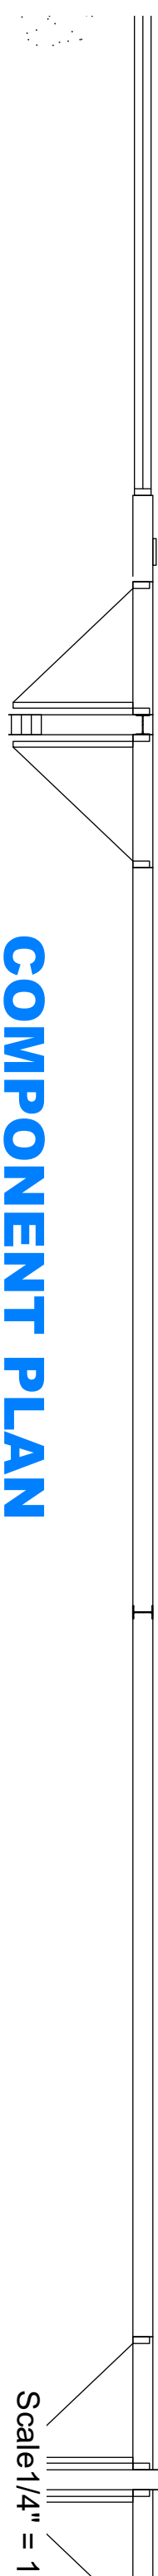

Scale 1/4" = 1



KEY PLAN

**MEDIA TECH ONLY
GROUND FLOOR
AUDIT Q#369640**



2595 BELLINGHAM TROY, MI 48068
(248) 823-5400 FAX: (248) 823-5400
WWW.YOURNBS.COM

NCIDQ SEAL

NOT FOR CONSTRUCTION

ALL STRUCTURAL, MECHANICAL & ELECTRICAL ENGINEERING IS THE RESPONSIBILITY OF OTHERS.

ALL FUTURE DESIGN DRAWINGS ARE IN CONFIDENCE. DISSEMINATION MAY NOT BE MADE WITHOUT PRIOR WRITTEN CONSENT OF NIS. ALL COMPANY LAWS/RIGHTS OF COPYRIGHT AND OTHERWISE ARE HEREBY SPECIFICALLY RESERVED.

PUMP, PLANT/ELECTRICITY FIT & PRACTICE IS SUBJECT TO ANY VARIATION FROM THIS PLAN DUE TO CIRCUMSTANCES, FIELD CONDITIONS, MATERIAL DIFFERENCES OR CHANGES REQUESTED FOR ANY REASON WITHIN COMPLIANCE TO NIS.

IF NIS DOES NOT DESIGN THIS PROJECT, NIS DOES NOT ASSUME RESPONSIBILITY FOR THE DESIGN SPECIFICATION ON PARTS OR APPLICATION OF PRODUCT'S INCLUDED IN THIS BID. NIS HAS ONLY RESPONDED TO THE PRICING REQUEST FOR THE

APPROVED BY: _____ DATE: _____

☐ APPROVED ☐ APPROVED AS NOTED

11/28/23	AUDIT MEDIA TECH
----------	------------------

OWNER:
LIVONIA PUBLIC
SCHOOLS

PROJECT:
HOOVER EL - MEDIA CENTER
RENOVATION


15900 LEVAN RD
LIVONIA, MI

PROJECT FOLDER:	23157
HEDBERG ORDER #:	TBI
ACCOUNT MANAGER:	M. DUGAN
DESIGNER:	S. MAZZARRA
PROJECT MANAGER	M. GREEN

COMPONENT PLAN

DRAWING NUMBER

ID-3.1

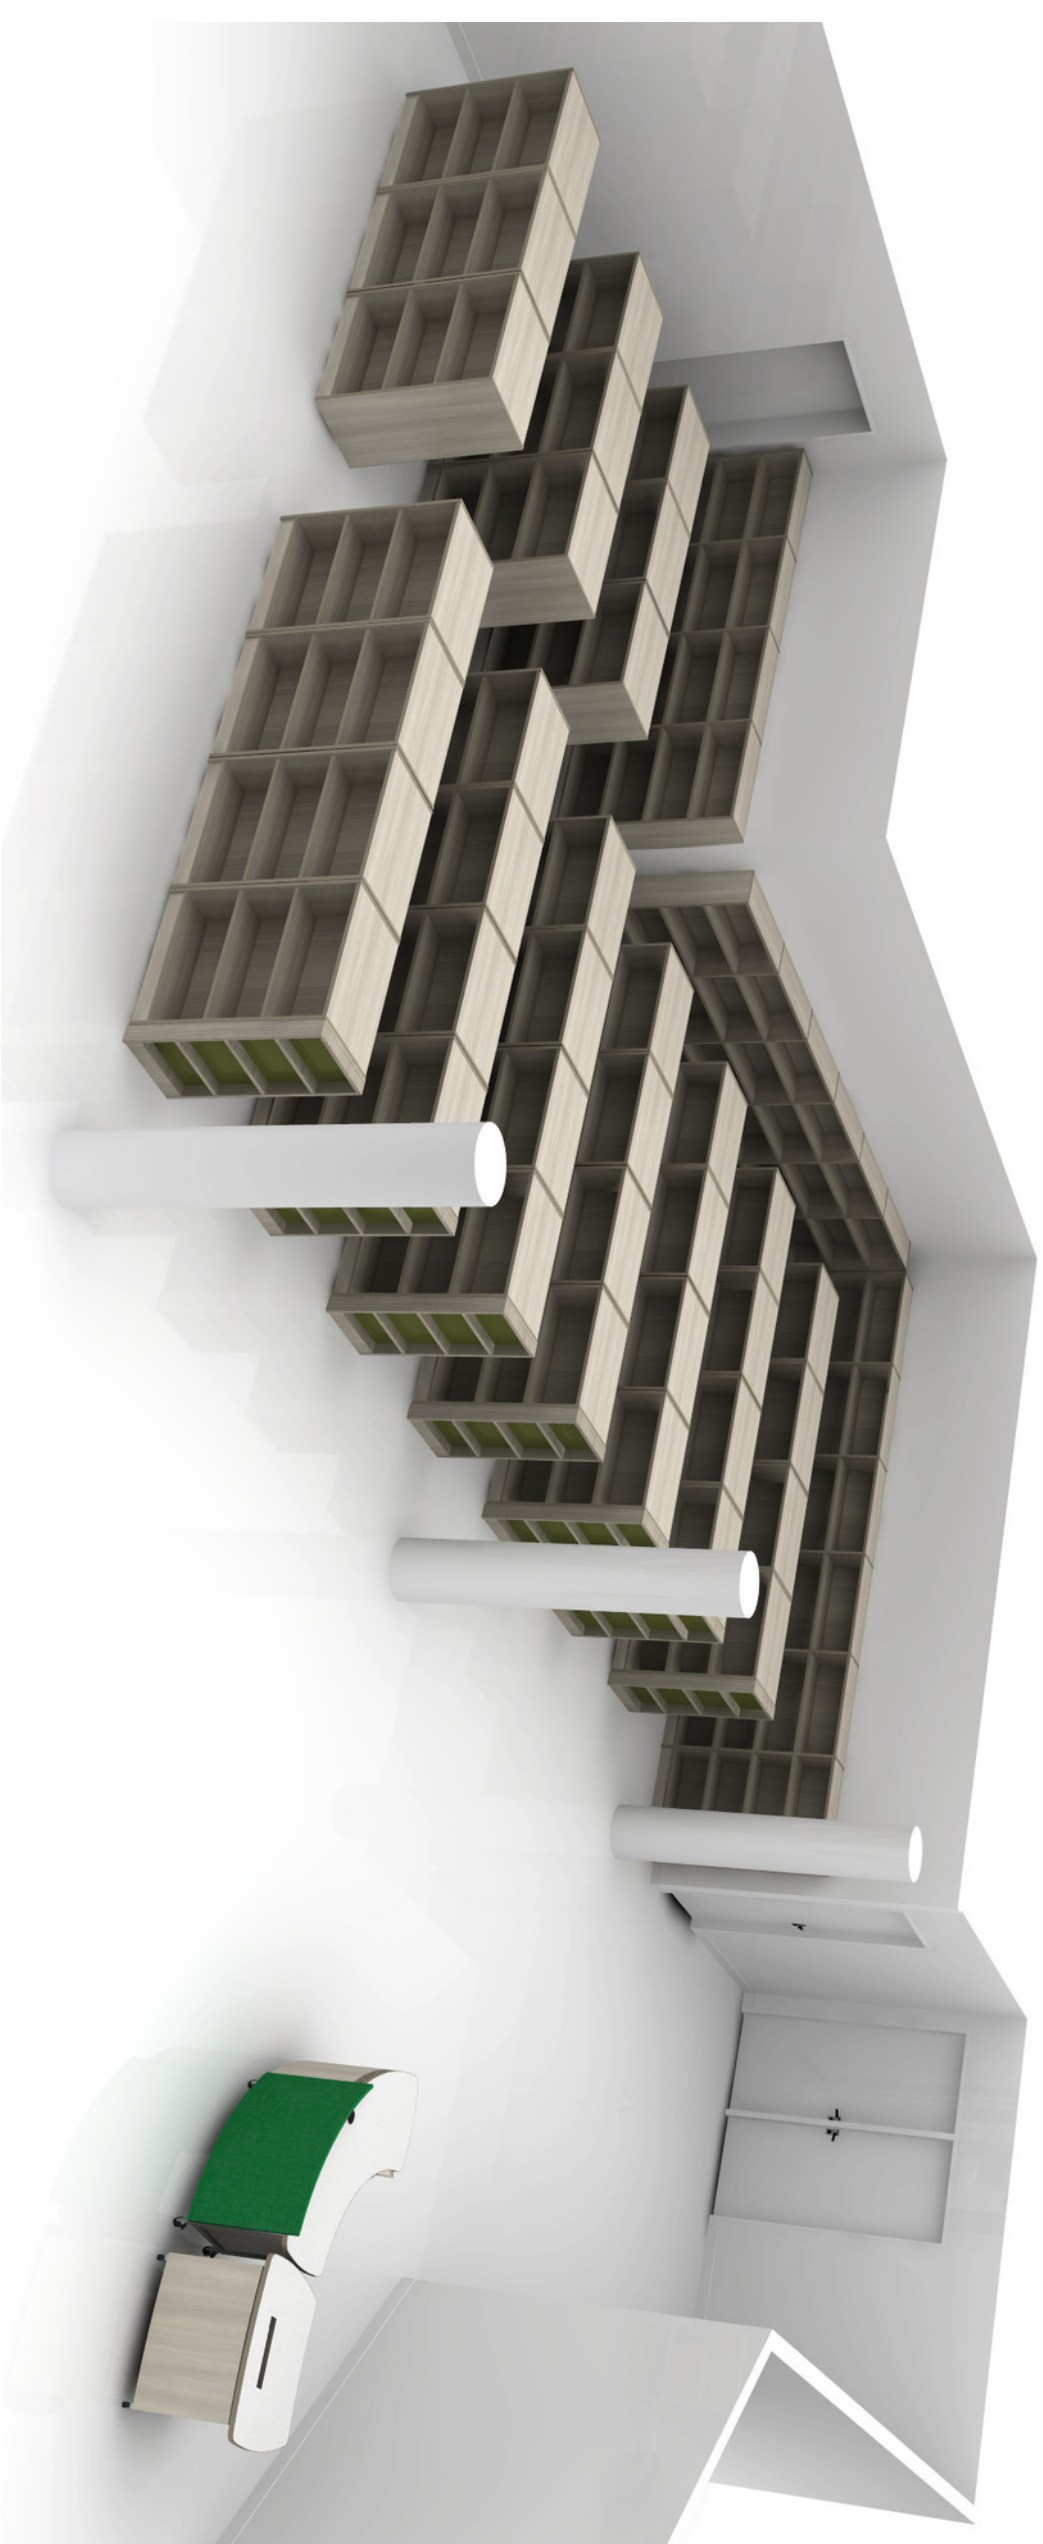

OVERALL RENDERINGS




PANEL HPL:
PREMIUM HPL:
GREYED OAK 5791

ACCENT PANEL:
WILSONART NORI 13091




PVC EDGE: SILVER GRAY
C600244
POWDER COAT: SILVER 809

CIRC DESK FINISHES

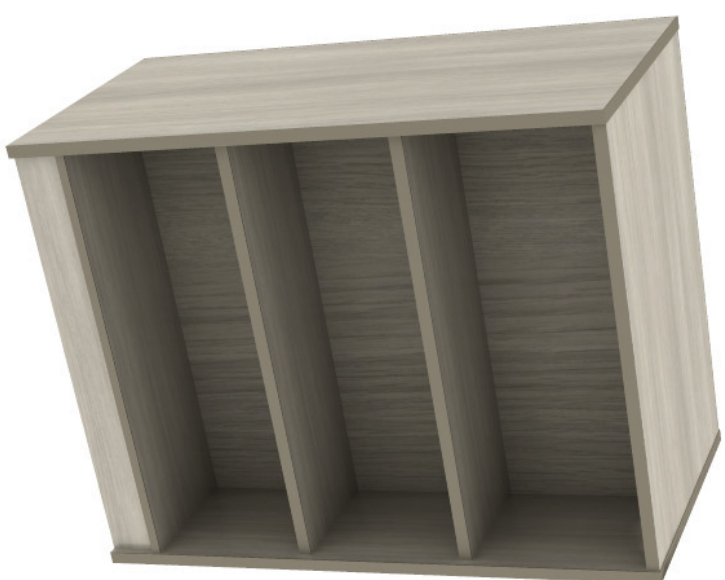

**MEDIA TECHNOLOGIES -
BENCHMARK 11 SERIES
MOBILE DOUBLE-FACED
36"W X 24"D X 48"H
BOOKSHELF**

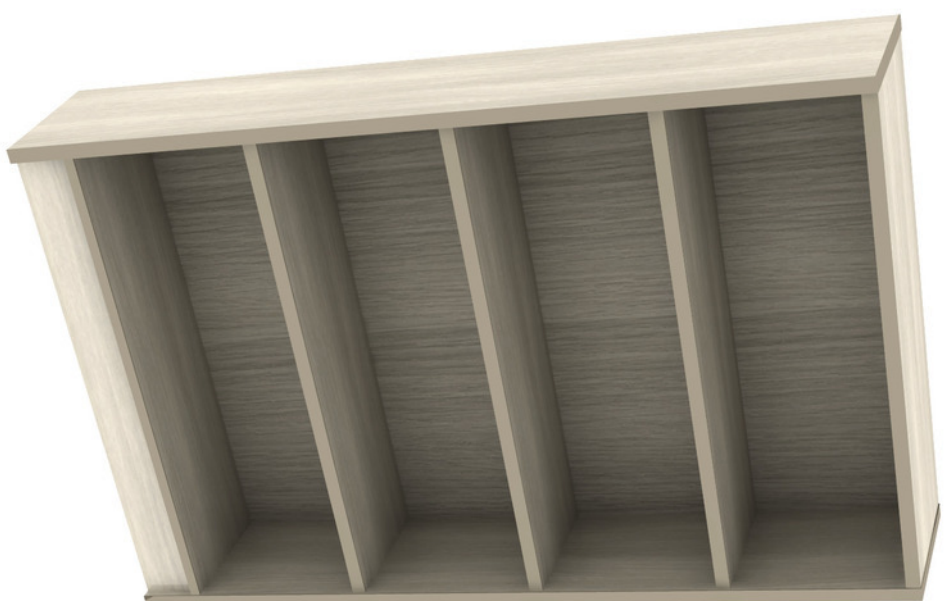

**MEDIA TECHNOLOGIES ·
BENCHMARK 11 SERIES
SINGLE-FACED
36"W X 12"D X 60"H
BOOKSHELF**



BOOKSHELF
PREMIUM HPL:
GREYED OAK 5791




DISPLAY BACK
PANEL:
HPL: FORMICA ALGAE
8796




PVC EDGE: SILVER GRAY
C600244

BOOKSHELF FINISHES

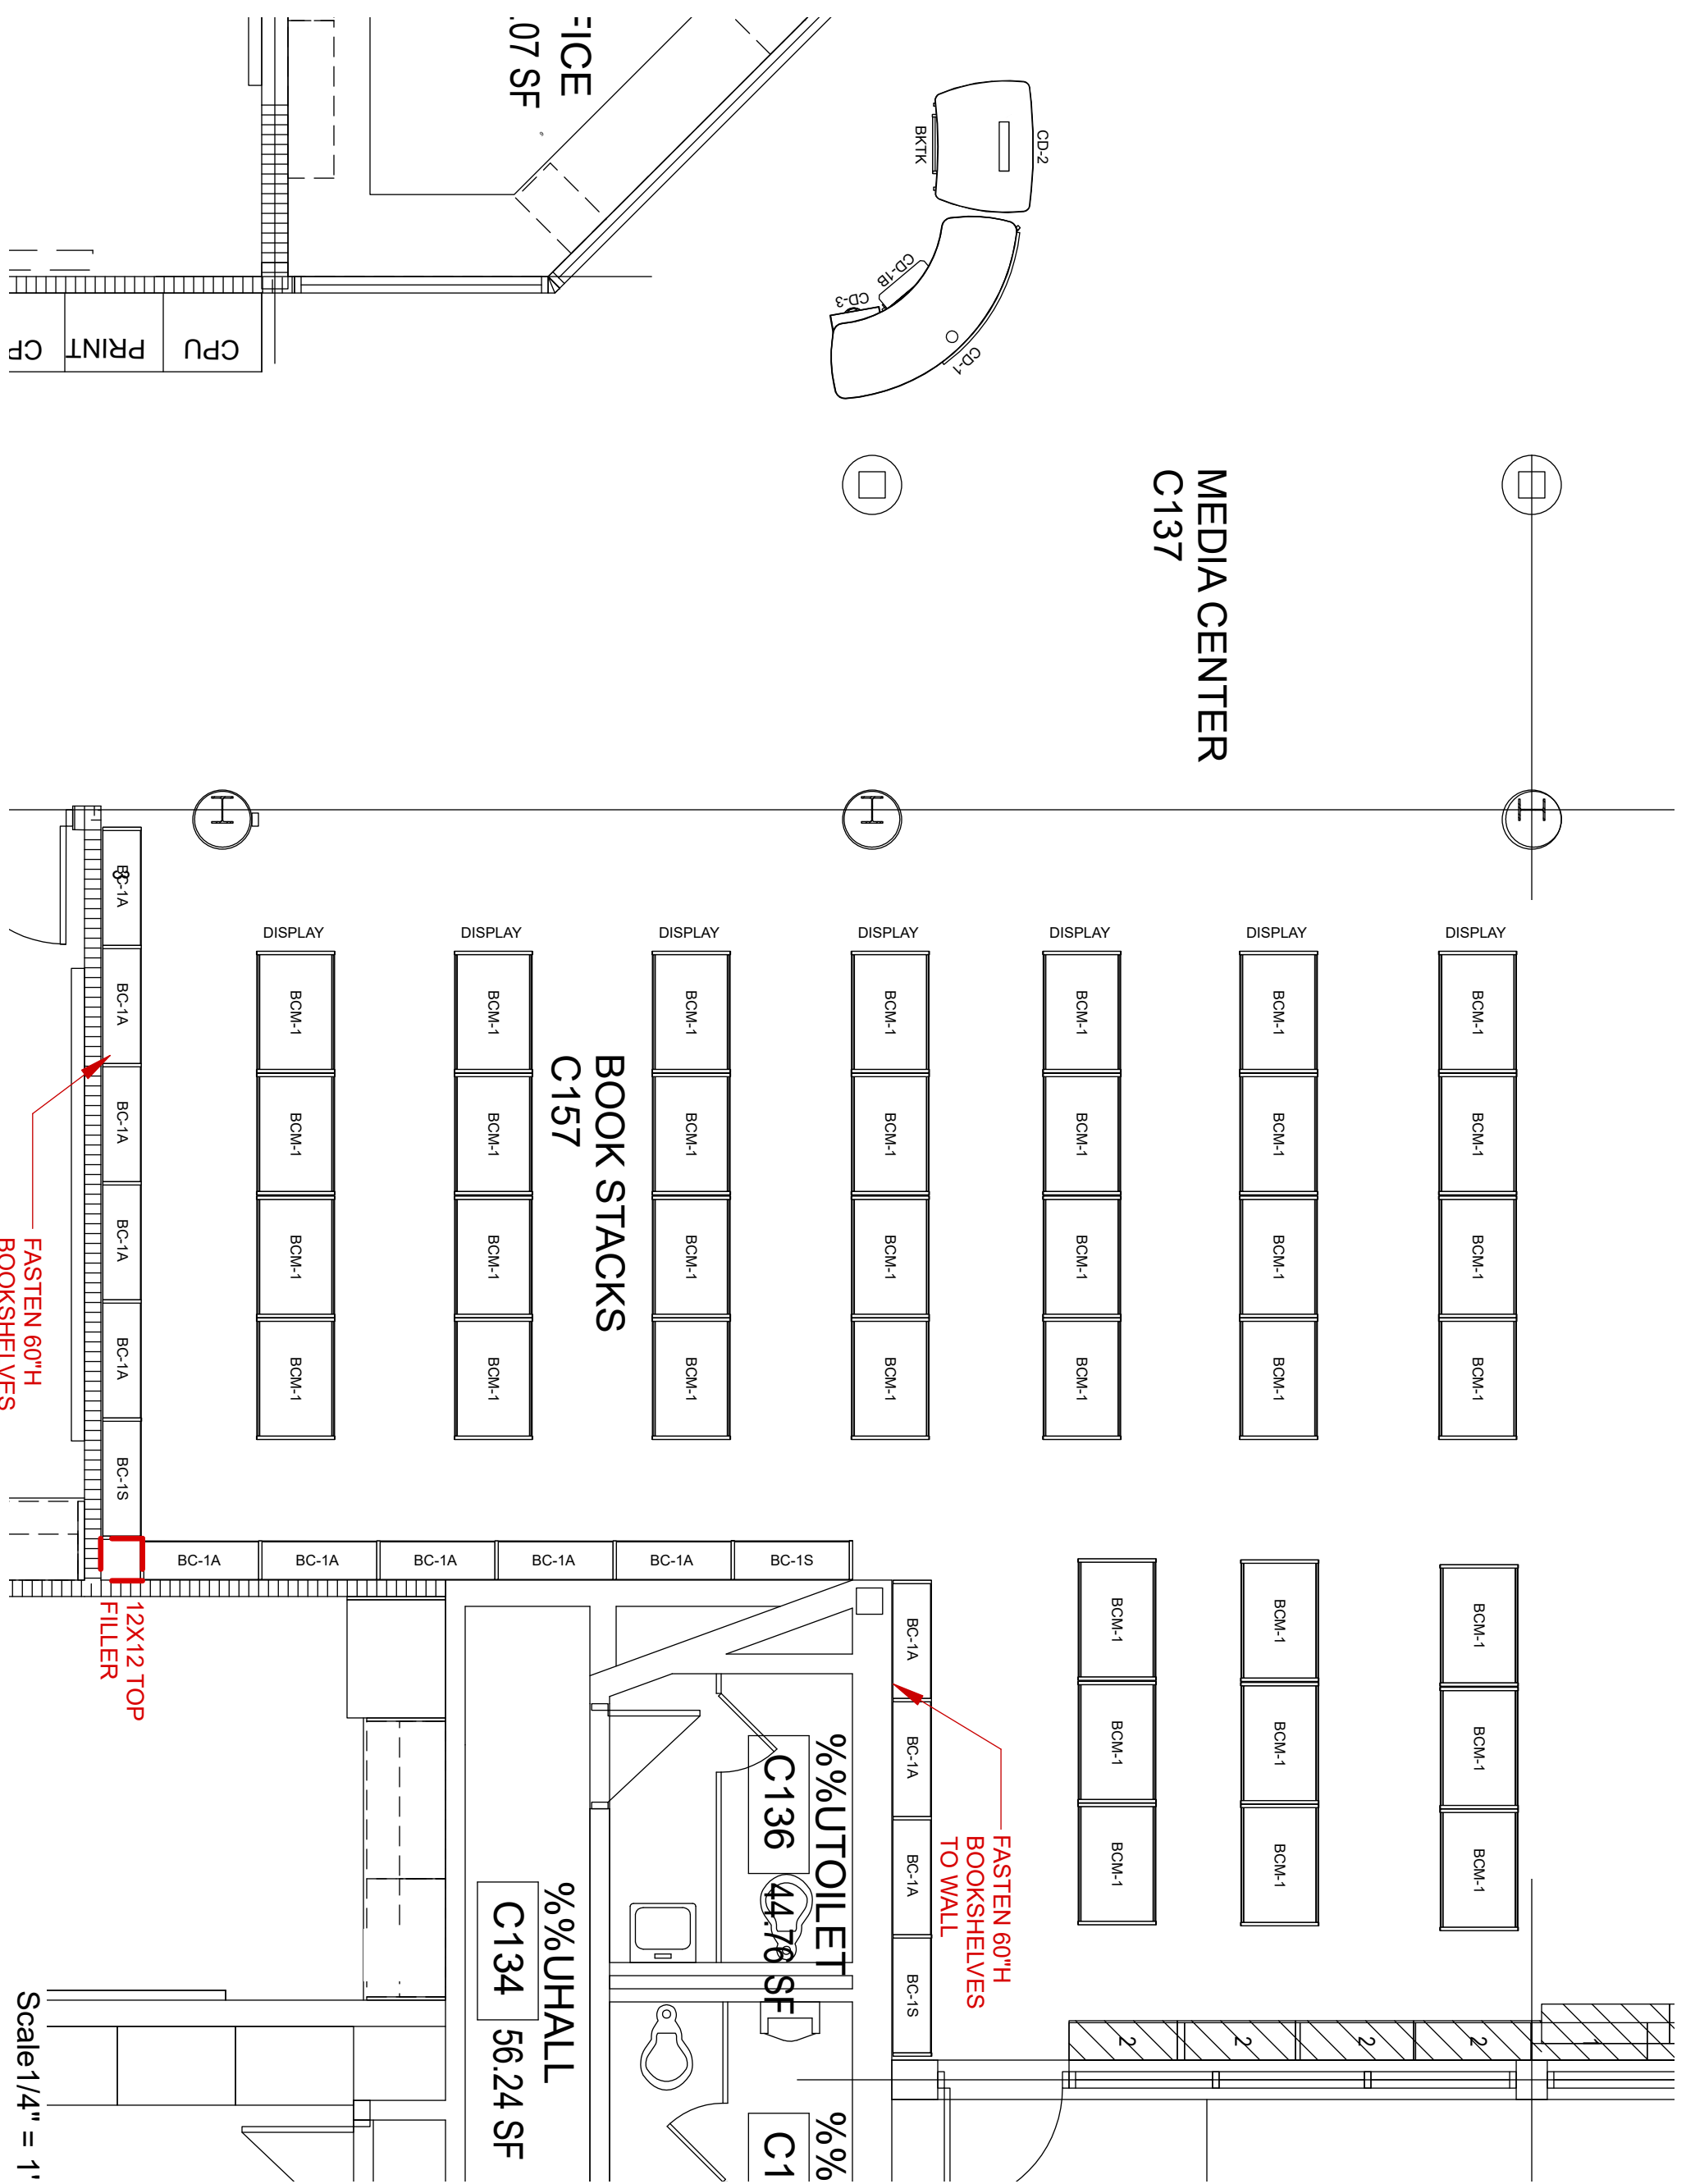

COMPONENT PLAN

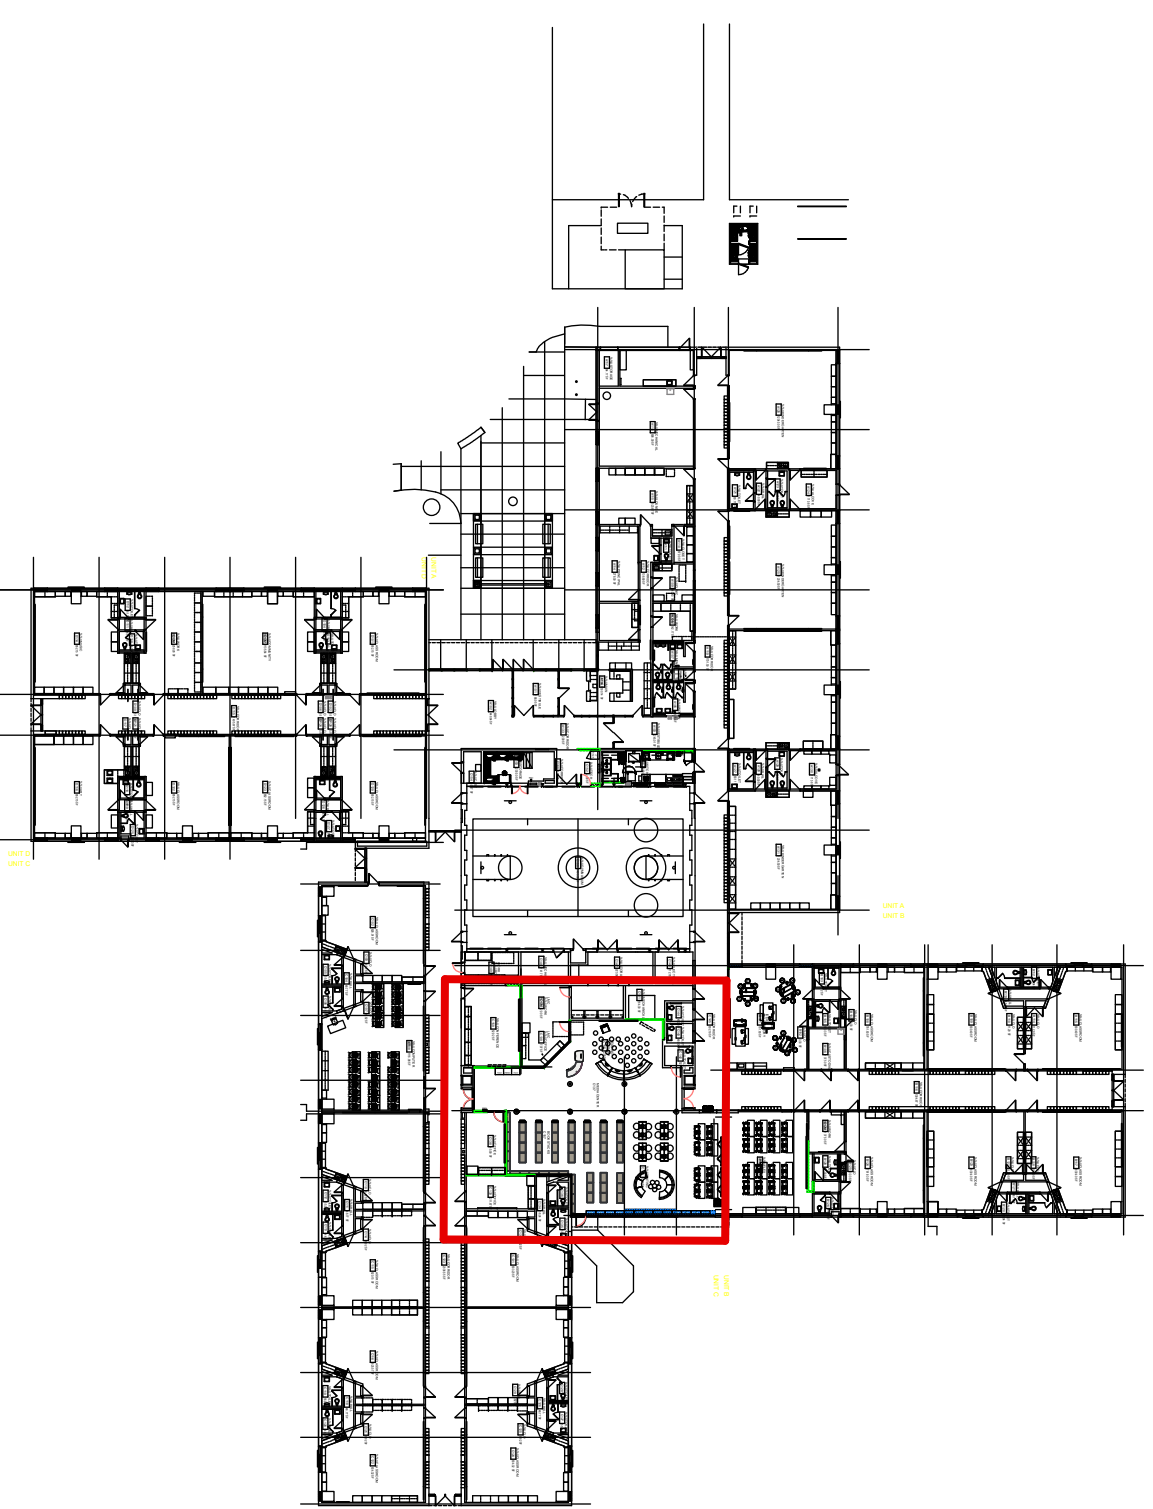

KEY PLAN

**MEDIA TECH ONLY
GROUND FLOOR
AUDIT Q#369670**



2595 BELLINGHAM TROY, MI 48068
(248) 823-5400 FAX: (248) 823-5400
WWW.YOURNBS.COM

INCIDQ SEAL

GENERAL NOTE:
NOT FOR CONSTRUCTION
ALL STRUCTURAL, MECHANICAL & ELECTRICAL ENGINEERING IS THE RESPONSIBILITY OF OTHERS.
IF NBS DOES NOT DESIGN THIS PROJECT, NBS DOES NOT ASSUME RESPONSIBILITY FOR THE DESIGN. THE DESIGNER SHALL BE RESPONSIBLE FOR THE DESIGN. IF NBS IS USED IN THIS PROJECT, NBS HAS ONLY RESPONDED TO THE PRICING REQUEST FOR THE PROJECT.

APPROVED BY: _____ DATE: _____

☐ APPROVED ☐ APPROVED AS NOTED

11/28/23	AUDIT MEDIA TECH
----------	------------------

LIVONIA PUBLIC
SCHOOLS

PROJECT:
HOLMES MS - MEDIA CENTER
RENOVATION

16200 NEWBURGH RD
LIVONIA, MI



PROJECT FOLDER:	23157
HEDBERG ORDER #:	TBI
ACCOUNT MANAGER:	MDUGAN
DESIGNER:	S.MAZZARANI
PROJECT MANAGER	M.GREEN

DRAWING

COMPONENT PLAN

DRAWING NUMBER

ID-3.1

 
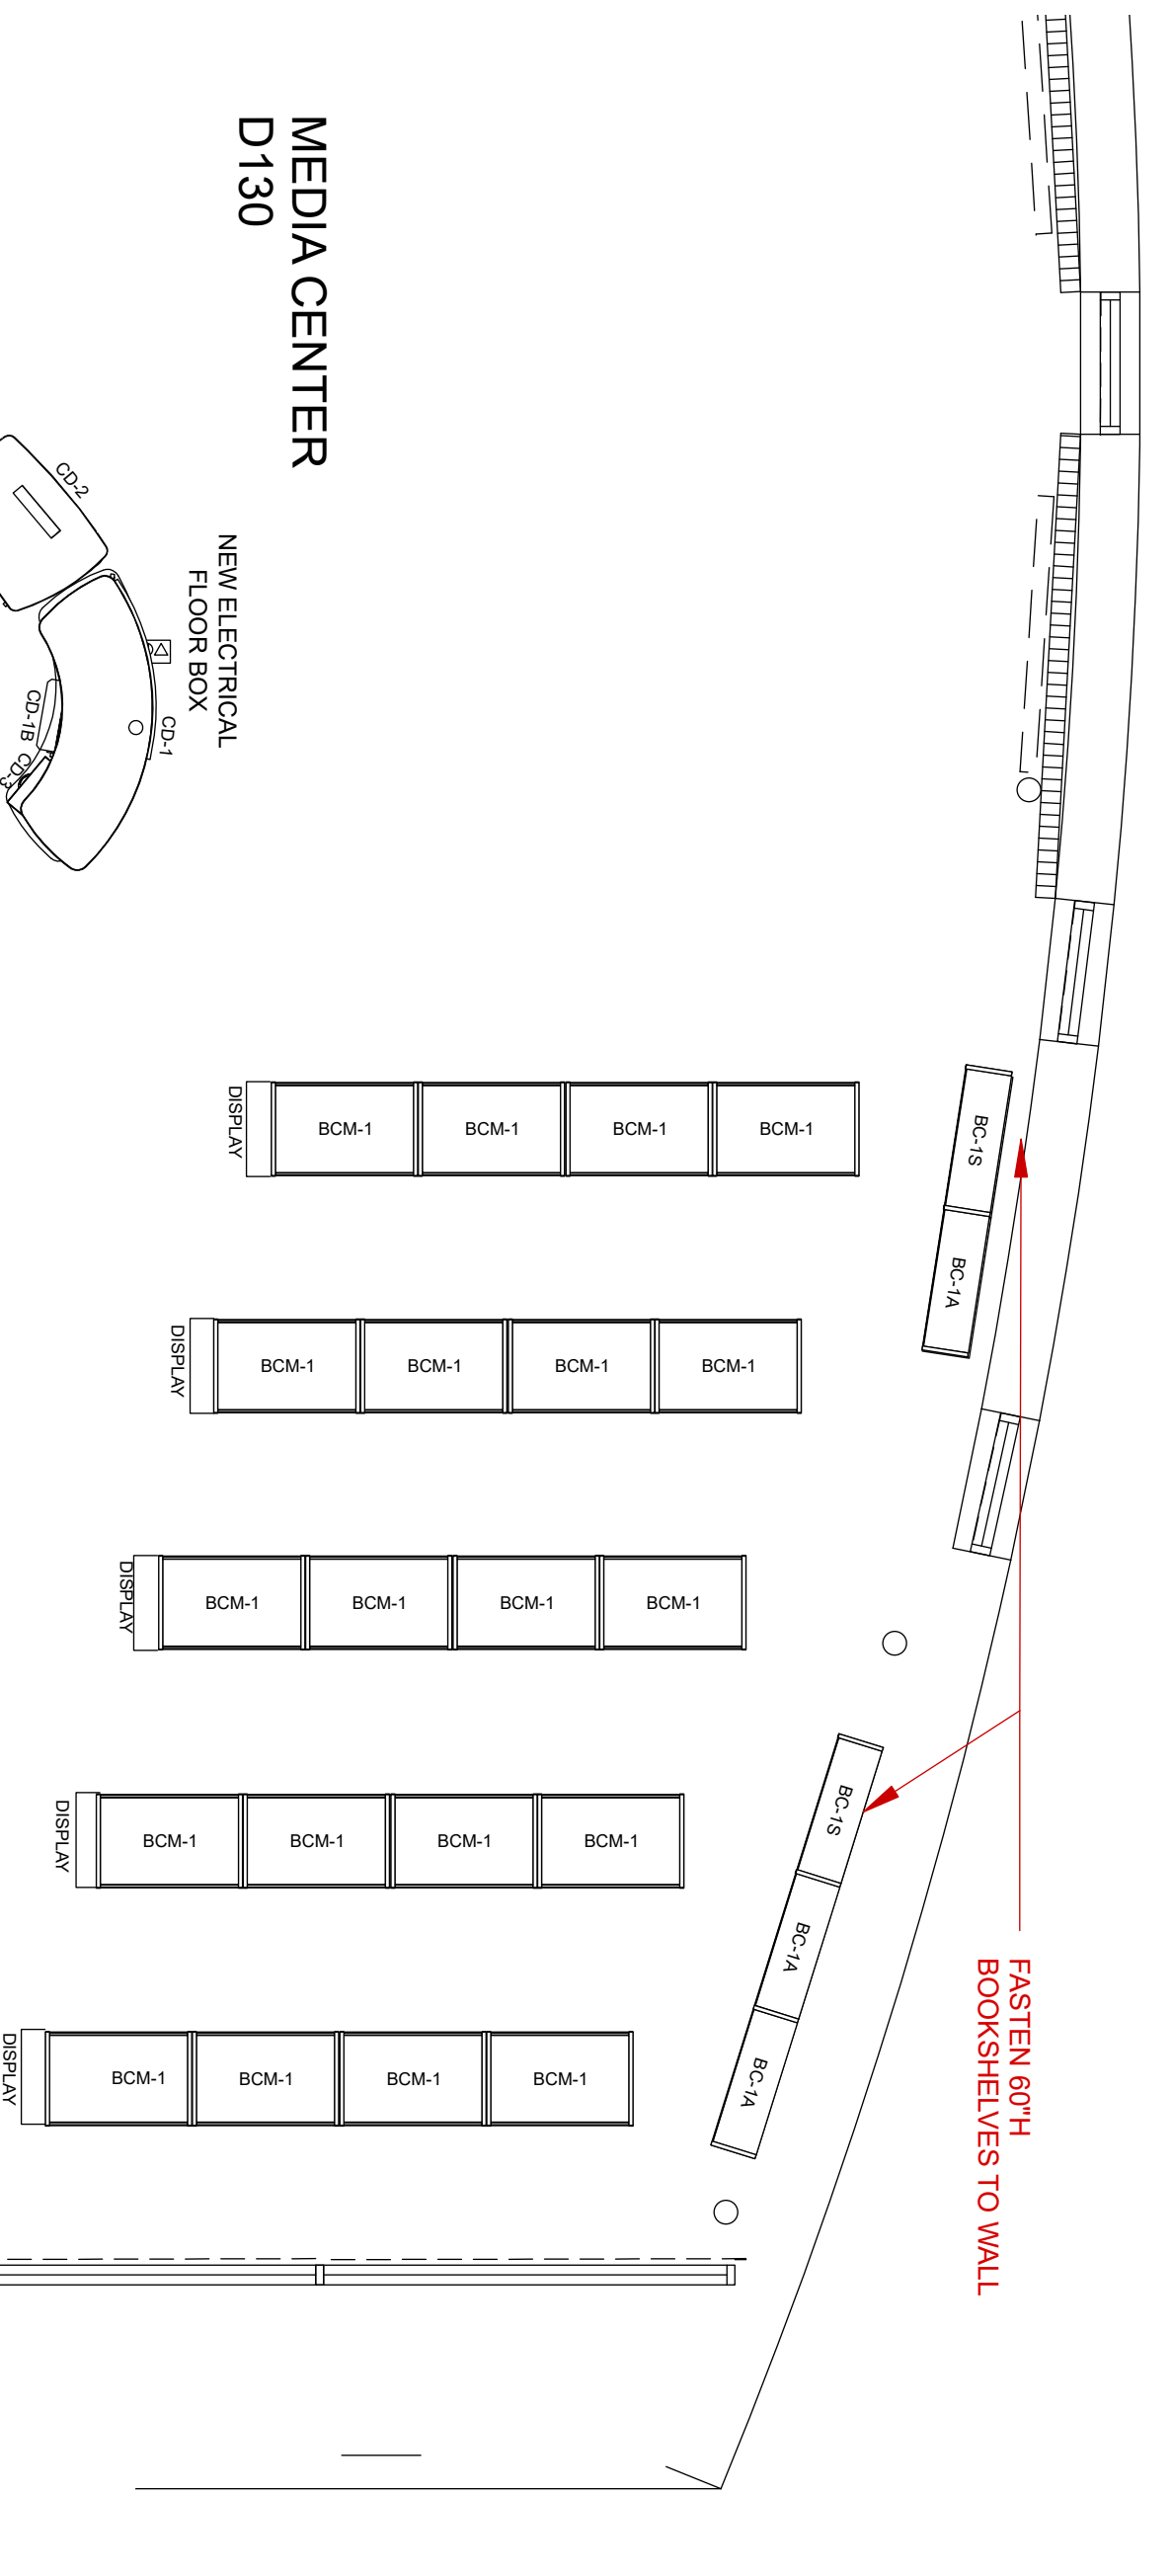


ACCENT PANEL:
WILSONART CATALINA
13092



DISPLAY BACK PANEL:
HPL: WILSONART
CATALINA 13092-30

KEY PLAN

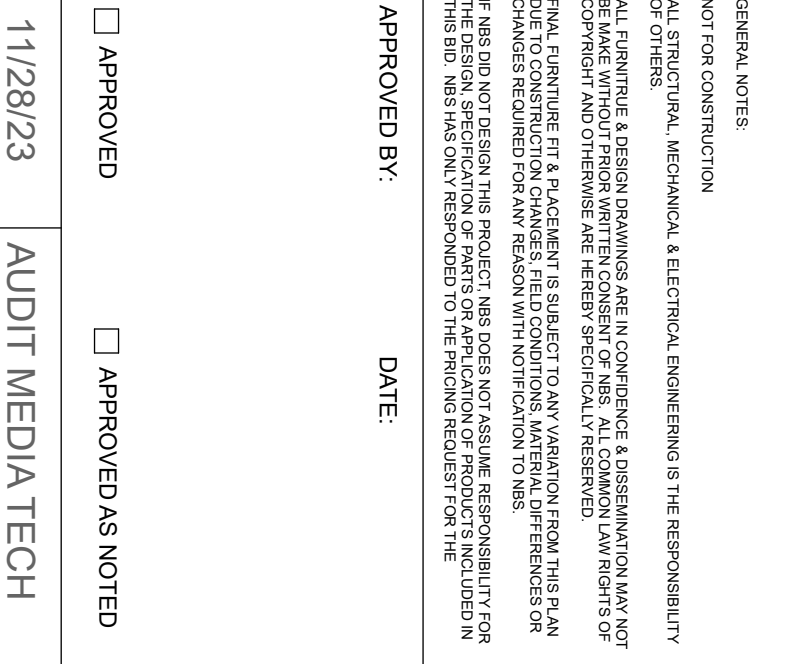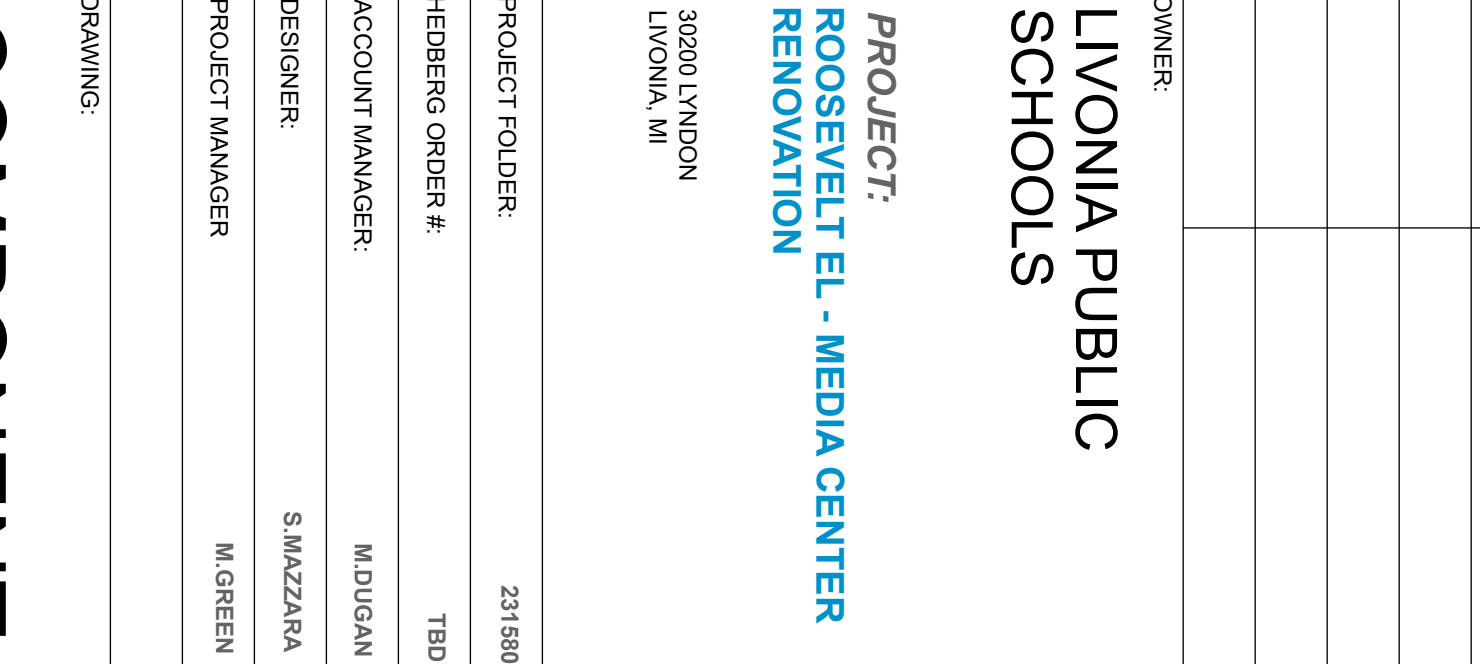

NEW ELECTRICAL

FASTEN 60"H
BOOKSHELVES TO WALL



NCIDQ SEAL

GENERAL NOTES

NOT FOR CONSTRUCTION





APPROVED BY: _____ DATE: _____

☐ APPROVED ☐ APPROVED AS NOTED

11/28/23	AUDIT MEDIA TECH
----------	------------------

OWNER:

LIVONIA PUBLIC
SCHOOLS

PROJECT:
ROOSEVELT EL - MEDIA CENTER
RENOVATION

30200 LYNDON
LIVONIA, MI

[illegible]

ACCOUNT MANAGER: M.DUGAN


DRAWING:

COMPONENT PLAN

DRAWING NUMBER:

ID-3.1

MEDIA TECH ONLY
GROUND FLOOR
AUDIT Q#369671



2595 Bellingham • Troy, MI 48083 • 248.823.5400 • 248.823.5401 Fax
2211 Old Earhart Rd. Ste.190 • Ann Arbor, MI 48105 • 248.823.5400 • 248.823.5401 Fax
3201 Pine Tree Rd. Ste. A • Lansing, MI 48911 • 517.886.0072 • 248.823.5401 Fax
5160 Alliance Dr. • Bay City, MI 48706 • 989.895.8574 • 989.895.8545 Fax
4 North St. Clair St. • Toledo, OH 43604 • 419.662.2040 • 248.823.5401 Fax

Quotation 369593

Quote Date 11/30/23

Customer Order

Project 231577

Customer L00002

Terms NET 10 DAYS

Expiration Date

Account Representative MONIQUE DUGAN

yourNBS.com

Remit Payments to: NBS, 6973 Reliable Parkway, Chicago, IL 60686

Quote To

Livonia Public Schools
15125 FARMINGTON RD
LIVONIA, MI, 48154-5413

Ship To

HARRY LAU
Hayes Elementary School
30600 Louise
Media Center
Westland, MI, 48185

Phone +1 (313) 523-9156

Fax +1 (734) 421-4870

Phone +1 (734) 744-2537

Cell +1 (734) 812-8597

hlau@livoniapublicschools.org

Sales Location Troy

This quote is valid for 30 days from date of quote.

The following contracts have been utilized for pricing on this quote:

NCPA contract

PO required to place order. Please reference NBS quote number on your PO.

Quote includes non-union straight time labor for NBS to receive, deliver and install; any owner requested changes requiring additional delivery trip(s) will result in additional charges to be quoted separately.

Receipt of PO indicates owner approval of product as specified; upon release of order, no changes, cancellations or returns can be made.

If there are project delays and product needs to be held past 30 days in the warehouse additional charges may be incurred by LPS

Media Tech product only

Balance of product needed to be quoted separately

PO needed by April 2024 to meet your target install date of August 2024

Description	Quantity	Unit Price	Extended Price
1 H11-4824-MOB - BENCHMARK SHELVEING, DBL FACE STARTER, MOBILE, TFL BACK, HPL PANEL & SHELVES 37"W X 24"D X 48"H HPL construction/3mm PVC edges, TFL back, 2 bases and 4 adjustable shelves, (4) casters HPL: FORMICA GREYED OAK 5791-PG PVC: SILVER GRAY C600244 TFL BACK: GREYED OAK 5791 MEDIA TECH	22	926.10	20,374.20

TITLE OF PRODUCT TRANSFERS UPON RECEIPT BY CUSTOMER.

ACCEPTED BY _____ TITLE _____ DATE _____

yourNBS.com

Remit Payments to: NBS, 6973 Reliable Parkway, Chicago, IL 60686

Description		Quantity	Unit Price	Extended Price
1	Tag For BCM-1			
2	DISP-4724 - Display End Panel, 3 opening, 23-3/4"W x 4"D x 47-3/8"H for use on V21-4824. HPL and 3mm PVC construction HPL: Formica Greyed Oak 5791-PG Interior Back HPL: WA Candy Apple 13096-60 (See layout) PVC: Silver Gray C600244 MEDIA TECH Tag For DISPLAY	6	706.05	4,236.30
3	H11-6012 - Benchmark, HPL Shelving Single Faced Starter 37"W x12"D x 60"H HPL construction/3mm PVC edges, TFL back, 1 base and 3 adjustable shelves. HPL: FORMICA GREYED OAK 5791-PG PVC: SILVER GRAY C600244 TFL BACK: GREYED OAK 5791 MEDIA TECH Tag For BC-1S	3	528.30	1,584.90
4	H11-6012A - Benchmark, HPL Shelving Single Faced Adder 36"W x12"D x 60"H HPL construction/3mm PVC edges, TFL back, 1 base and 3 adjustable shelves. HPL: FORMICA GREYED OAK 5791-PG PVC: SILVER GRAY C600244 TFL BACK: GREYED OAK 5791 MEDIA TECH Tag For BC-1A	10	436.95	4,369.50
5	TOPFILL1212T - TOP FILLER FOR BOOKCASEA 12" X 12" WITH MOUNTING HARDWARE HPL: FORMICA GREYED OAK 5791-PG PVC: SILVER GRAY C600244 MEDIA TECH Tag For 12X12TOP FILLER	1	41.85	41.85
6	31-LK - LEVELING KIT FOR USE ON 11/21/31 SERIES SHELIVING MEDIA TECH Tag For LEVELING	16	6.75	108.00
9	ND-75DXL-MOB - Nomad Mobile Desk no transaction top 24"Dx75"Wx29"H Mobile 29"H worksurface with grommet no Transaction top,	1	3,636.45	3,636.45

TITLE OF PRODUCT TRANSFERS UPON RECEIPT BY CUSTOMER.

ACCEPTED BY _____ TITLE _____ DATE _____

yourNBS.com

Remit Payments to: NBS, 6973 Reliable Parkway, Chicago, IL 60686

Description	Quantity	Unit Price	Extended Price
9 3mm PVC Edge, (5) locking casters. Left hand front A: HPL Main (large) Front: WA Catalina 13092-60 B: HPL Front Accent (small) Panel: Formica Greyed Oak 5791-PG C: HPL End Panel: Formica Greyed Oak 5791-PG D: HPL Work Surface & Trans Top: Nevamar White Fiesta MW550-SD D: PVC Work Surface & Trans Top: Silver Gray C600244 E: Powder Coat: 809 Silver MEDIA TECH Tag For CIRCULATION DESK CD-1			
10 MCD-1817 - STEEL CENTER DRAWER 18"W X 17"D X 2"H FINISH: BLACK MEDIA TECH Tag For CIRCULATION DESK CD-1B	1	192.60	192.60
11 WMPS661220-W-LL-P2A - Mobile Pedestal, 2 Box, 1 File Drawers 14-13/16"W x 20-3/4"D x 27"H HPL: Formica Greyed Oak 5791-60 PVC: Silver Gray C600244 Pulls: P2 Nickel LOCK FINISH: Nickel MEDIA TECH Tag For CIRCULATION DESK CD-3	1	509.85	509.85
12 ND-40BR-MOB - Nomad Book Return 30"Dx40"Wx29"H, Mobile HPL/3mm PVC top with radiused corners, book return slot in top, Curved face, steel end frames with floating HPL panel, 4 locking casters. For use with MCD-DBTL1824-24 Depressible Book Truck (not included). Powder coat 809 Silver. B: HPL Front Panel: Formica Greyed Oak 5791-PG C: HPL End Panel: Formica Greyed Oak 5791-PG D: HPL Work Surface: Nevamar White Fiesta MW550-SD	1	1,759.05	1,759.05

TITLE OF PRODUCT TRANSFERS UPON RECEIPT BY CUSTOMER.

ACCEPTED BY _____ TITLE _____ DATE _____

yourNBS.com

Remit Payments to: NBS, 6973 Reliable Parkway, Chicago, IL 60686

Description	Quantity	Unit Price	Extended Price
12 D: PVC Work Surface: Silver Gray C600244 E: Powder Coat: 809 Silver MEDIA TECH Tag For CIRCULATION DESK CD-2			
13 MCD-DBTL-1824-24 - Depressible Platform Book Truck, 18"Dx24.25"Wx24"H HPL construction with 3mm PVC edge banding, spring-loaded platform lift mechanism. HPL: Formica Greyed Oak 5791-PG PVC Edge: Silver Grey C600244 MEDIA TECH Tag For CIRCULATION DESK BKTK	1	1,327.50	1,327.50
14 LOT - MEDIA TECH NON-STANDARD TFL UPCHARGE MEDIA TECH	1	1,039.50	1,039.50
15 LOT - MEDIA TECH PREMIUM LAMINATE UPCHARGE MEDIA TECH	1	749.25	749.25
16 2024 UPCHARGE - 2024 PRICE INCREASE UPCHARGE MEDIA TECH	1	1,961.10	1,961.10
17 LOT - NON UNION STRAIGHT TIME LABOR TO RECEIVE, DELIVER AND INSTALL NEW PRODUCT PER PRINT ALL WORK TO BE DONE AT ONE TIME INCLUDES BOLTING THE BOOKCASES TO THE WALLS SITE TO BE SEMI-TRUCK ACCESSIBLE PRICING DOES NOT INCLUDE THE REMOVAL OR RELOCATION OF EXISTING PRODUCT ROSE MOVIN	1	6,705.00	6,705.00

Quotation Totals

Sub Total	48,595.05
MEDIA TECH FREIGHT	1,267.00
Grand Total	49,862.05

End of Quotation

TITLE OF PRODUCT TRANSFERS UPON RECEIPT BY CUSTOMER.

ACCEPTED BY _____ TITLE _____ DATE _____



2595 Bellingham • Troy, MI 48083 • 248.823.5400 • 248.823.5401 Fax
2211 Old Earhart Rd. Ste.190 • Ann Arbor, MI 48105 • 248.823.5400 • 248.823.5401 Fax
3201 Pine Tree Rd. Ste. A • Lansing, MI 48911 • 517.886.0072 • 248.823.5401 Fax
5160 Alliance Dr. • Bay City, MI 48706 • 989.895.8574 • 989.895.8545 Fax
4 North St. Clair St. • Toledo, OH 43604 • 419.662.2040 • 248.823.5401 Fax

Quotation 369672

Quote Date 11/30/23

Customer Order

Project 231581

Customer L00002

Terms NET 10 DAYS

Expiration Date

Account Representative MONIQUE DUGAN

yourNBS.com

Remit Payments to: NBS, 6973 Reliable Parkway, Chicago, IL 60686

Quote To

Livonia Public Schools
15125 FARMINGTON RD
LIVONIA, MI, 48154-5413

Ship To

HARRY LAU
Stevenson High School
33500 Six Mile Rd
Media Center - Media Tech Product
LIVONIA, MI, 48154-5413

Phone +1 (313) 523-9156

Fax +1 (734) 421-4870

Phone +1 (734) 744-2537

Cell +1 (734) 812-8597

hlau@livoniapublicschools.org

Sales Location Troy

This quote is valid for 30 days from date of quote.

The following contracts have been utilized for pricing on this quote:

NCPA contract

PO required to place order. Please reference NBS quote number on your PO.

Quote includes non-union straight time labor for NBS to receive, deliver and install; any owner requested changes requiring additional delivery trip(s) will result in additional charges to be quoted separately.

Receipt of PO indicates owner approval of product as specified; upon release of order, no changes, cancellations or returns can be made.

If there are project delays and product needs to be held past 30 days in the warehouse additional charges may be incurred by LPS

Media Tech product only

Balance of product needed to be quoted separately

PO needed by April 2024 to meet your target install date of August 2024

Description	Quantity	Unit Price	Extended Price
1 H11-4824-MOB - BENCHMARK SHELVING, DBL FACE STARTER, MOBILE, TFL BACK, HPL PANEL & SHELVES 37"W X 24"D X 48"H HPL construction/3mm PVC edges, TFL back, 2 bases and 4 adjustable shelves, (4) casters HPL: FORMICA GREYED OAK 5791-PG PVC: SILVER GRAY C600244 TFL BACK: GREYED OAK 5791 MEDIA TECH	52	926.10	48,157.20

TITLE OF PRODUCT TRANSFERS UPON RECEIPT BY CUSTOMER.

ACCEPTED BY _____ TITLE _____ DATE _____

yourNBS.com

Remit Payments to: NBS, 6973 Reliable Parkway, Chicago, IL 60686

Description		Quantity	Unit Price	Extended Price
1	Tag For BCM-1			
2	DISP-4724 - Display End Panel, 3 opening, 23-3/4"W x 4"D x 47-3/8"H for use on V21-4824. HPL and 3mm PVC construction HPL: Formica Greyed Oak 5791-PG Interior Back HPL: Pionite Navy Blue SB007-SD PVC: Silver Gray C600244 MEDIA TECH Tag For DISPLAY	8	706.05	5,648.40
3	H11-7212 - Benchmark, HPL Shelving Single Faced Starter 37"W x 12"D x 72"H HPL construction/3mm PVC edges, TFL back, 1 base and 3 adjustable shelves. HPL: FORMICA GREYED OAK 5791-PG PVC: SILVER GRAY C600244 TFL BACK: GREYED OAK 5791 MEDIA TECH Tag For BC-1S	4	754.65	3,018.60
4	H11-7212A - Benchmark, HPL Shelving Single Faced Adder 36"W x 12"D x 72"H HPL construction/3mm PVC edges, TFL back, 1 base and 3 adjustable shelves. HPL: FORMICA GREYED OAK 5791-PG PVC: SILVER GRAY C600244 TFL BACK: GREYED OAK 5791 MEDIA TECH Tag For BC-1A	22	670.05	14,741.10
5	TOPFILL1212T - TOP FILLER FOR BOOKCASEA 12" X 12" WITH MOUNTING HARDWARE HPL: FORMICA GREYED OAK 5791-PG PVC: SILVER GRAY C600244 MEDIA TECH Tag For 12X12TOP FILLER	1	41.85	41.85
6	31-LK - LEVELING KIT FOR USE ON 11/21/31 SERIES SHELIVING MEDIA TECH Tag For LEVELING	30	6.75	202.50
7	ND-75DL-MOB - Nomad Desk, TRX Top Left, 24"D x 75"W x 29"/35"H, Mobile - 809 Silver 970-067140-000-G0809 29"H HPL worksurface with grommet, Left	1	3,823.20	3,823.20

TITLE OF PRODUCT TRANSFERS UPON RECEIPT BY CUSTOMER.

ACCEPTED BY _____ TITLE _____ DATE _____



yourNBS.com

Remit Payments to: NBS, 6973 Reliable Parkway, Chicago, IL 60686

Description	Quantity	Unit Price	Extended Price
<p>7 Hand 6"H Transaction HPL top, 3mm PVC Edge, 809 Silver powder coated steel components, (5) locking casters.</p> <p>A: HPL Main (large) Front: Pionite Navy Blue SB007-SD</p> <p>B: HPL Front Accent (small) Panel: Formica Greyed Oak 5791-PG</p> <p>C: HPL End Panel: Formica Greyed Oak 5791-PG</p> <p>D: HPL Work Surface & Trans Top: Nevamar White Fiesta MW550-SD</p> <p>D: PVC Work Surface & Trans Top: Silver Gray C600244</p> <p>E: Powder Coat: 809 Silver MEDIA TECH</p> <p>Tag For CIRCULATION DESK CD-1</p>			
<p>8 MCD-1817 - STEEL CENTER DRAWER 18"W X 17"D X 2"H FINISH: BLACK MEDIA TECH Tag For CIRCULATION DESK CD-1B</p>	1	192.60	192.60
<p>9 WMPS661220-W-LL-P2A - Mobile Pedestal, 2 Box, 1 File Drawers 14-13/16"W x 20-3/4"D x 27"H HPL: Formica Greyed Oak 5791-60 PVC: Silver Gray C600244 Pulls: P2 Nickel LOCK FINISH: Nickel MEDIA TECH Tag For CIRCULATION DESK CD-3</p>	1	509.85	509.85
<p>10 ND-40BR-MOB - Nomad Book Return 30"Dx40"Wx29"H, Mobile HPL/3mm PVC top with radiused corners, book return slot in top, Curved face, steel end frames with floating</p> <p>HPL panel, 4 locking casters. For use with</p> <p>MCD-DBTL1824-24 Depressible Book Truck (not included). Powder coat 809 Silver.</p> <p>B: HPL Front Panel: Formica Greyed Oak 5791-PG</p> <p>C: HPL End Panel: Formica Greyed Oak 5791-PG</p>	1	1,759.05	1,759.05

TITLE OF PRODUCT TRANSFERS UPON RECEIPT BY CUSTOMER.

ACCEPTED BY _____ TITLE _____ DATE _____

yourNBS.com

Remit Payments to: NBS, 6973 Reliable Parkway, Chicago, IL 60686

Description	Quantity	Unit Price	Extended Price
10 D: HPL Work Surface: Nevamar White Fiesta MW550-SD D: PVC Work Surface: Silver Gray C600244 E: Powder Coat: 809 Silver MEDIA TECH Tag For CIRCULATION DESK CD-2			
11 MCD-DBTL-1824-24 - Depressible Platform Book Truck, 18"Dx24.25"Wx24"H HPL construction with 3mm PVC edge banding, spring-loaded platform lift mechanism. HPL: Formica Greyed Oak 5791-PG PVC Edge: Silver Grey C600244 MEDIA TECH Tag For CIRCULATION DESK BKTK	1	1,327.50	1,327.50
12 LOT - MEDIA TECH NON-STANDARD TFL UPCHARGE MEDIA TECH	1	2,638.80	2,638.80
13 LOT - MEDIA TECH PREMIUM LAMINATE UPCHARGE MEDIA TECH	1	1,573.20	1,573.20
14 2024 UPCHARGE - 2024 PRICE INCREASE UPCHARGE MEDIA TECH	1	4,139.10	4,139.10
15 LOT - NON UNION STRAIGHT TIME LABOR TO RECEIVE, DELIVER AND INSTALL NEW PRODUCT PER PRINT ALL WORK TO BE DONE AT ONE TIME INCLUDES BOLTING THE BOOKCASES TO THE WALLS SITE TO BE SEMI-TRUCK ACCESSIBLE PRICING DOES NOT INCLUDE THE REMOVAL OR RELOCATION OF EXISTING PRODUCT ROSE MOVIN	1	12,383.00	12,383.00

Quotation Totals

Sub Total	100,155.95
MEDIA TECH FREIGHT	1,667.00
Grand Total	101,822.95

End of Quotation

TITLE OF PRODUCT TRANSFERS UPON RECEIPT BY CUSTOMER.

ACCEPTED BY _____ TITLE _____ DATE _____



2595 Bellingham • Troy, MI 48083 • 248.823.5400 • 248.823.5401 Fax
2211 Old Earhart Rd. Ste.190 • Ann Arbor, MI 48105 • 248.823.5400 • 248.823.5401 Fax
3201 Pine Tree Rd. Ste. A • Lansing, MI 48911 • 517.886.0072 • 248.823.5401 Fax
5160 Alliance Dr. • Bay City, MI 48706 • 989.895.8574 • 989.895.8545 Fax
4 North St. Clair St. • Toledo, OH 43604 • 419.662.2040 • 248.823.5401 Fax

Quotation 369670
Quote Date 11/30/23
Customer Order
Project 231577
Customer L00002
Terms NET 10 DAYS
Expiration Date
Account Representative MONIQUE DUGAN

yourNBS.com **Remit Payments to:** NBS, 6973 Reliable Parkway, Chicago, IL 60686

Quote To

Livonia Public Schools
15125 FARMINGTON RD
LIVONIA, MI, 48154-5413

Ship To

HARRY LAU
Holmes Elementary
16200 Newburgh Rd
Media Center - Media Tech Product
LIVONIA, MI, 48154-5413

Phone +1 (313) 523-9156

Fax +1 (734) 421-4870

Phone +1 (734) 744-2537
Cell +1 (734) 812-8597

hlau@livoniapublicschools.org
Sales Location Troy

This quote is valid for 30 days from date of quote.

The following contracts have been utilized for pricing on this quote:
NCPA contract

PO required to place order. Please reference NBS quote number on your PO.

Quote includes non-union straight time labor for NBS to receive, deliver and install; any owner requested changes requiring additional delivery trip(s) will result in additional charges to be quoted separately.

Receipt of PO indicates owner approval of product as specified; upon release of order, no changes, cancellations or returns can be made.

If there are project delays and product needs to be held past 30 days in the warehouse additional charges may be incurred by LPS

Media Tech product only
Balance of product needed to be quoted separately

PO needed by April 2024 to meet your target install date of August 2024

Description	Quantity	Unit Price	Extended Price
1 H11-4824-MOB - BENCHMARK SHELVING, DBL FACE STARTER, MOBILE, TFL BACK, HPL PANEL & SHELVES 37"W X 24"D X 48"H HPL construction/3mm PVC edges, TFL back, 2 bases and 4 adjustable shelves, (4) casters HPL: FORMICA GREYED OAK 5791-PG PVC: SILVER GRAY C600244 TFL BACK: GREYED OAK 5791 MEDIA TECH	37	926.10	34,265.70

TITLE OF PRODUCT TRANSFERS UPON RECEIPT BY CUSTOMER.

ACCEPTED BY _____ TITLE _____ DATE _____

yourNBS.com

Remit Payments to: NBS, 6973 Reliable Parkway, Chicago, IL 60686

Description		Quantity	Unit Price	Extended Price
1	Tag For BCM-1			
2	DISP-4724 - Display End Panel, 3 opening, 23-3/4"W x 4"D x 47-3/8"H for use on V21-4824. HPL and 3mm PVC construction HPL: Formica Greyed Oak 5791-PG Interior Back HPL: Formica Algae 8796-58 PVC: Silver Gray C600244 MEDIA TECH Tag For DISPLAY	7	706.05	4,942.35
3	H11-6012 - Benchmark, HPL Shelving Single Faced Starter 37"W x12"D x 60"H HPL construction/3mm PVC edges, TFL back, 1 base and 3 adjustable shelves. HPL: FORMICA GREYED OAK 5791-PG PVC: SILVER GRAY C600244 TFL BACK: GREYED OAK 5791 MEDIA TECH Tag For BC-1S	3	528.30	1,584.90
4	H11-6012A - Benchmark, HPL Shelving Single Faced Adder 36"W x12"D x 60"H HPL construction/3mm PVC edges, TFL back, 1 base and 3 adjustable shelves. HPL: FORMICA GREYED OAK 5791-PG PVC: SILVER GRAY C600244 TFL BACK: GREYED OAK 5791 MEDIA TECH Tag For BC-1A	13	436.95	5,680.35
5	TOPFILL1212T - TOP FILLER FOR BOOKCASEA 12" X 12" WITH MOUNTING HARDWARE HPL: FORMICA GREYED OAK 5791-PG PVC: SILVER GRAY C600244 MEDIA TECH Tag For 12X12TOP FILLER	1	41.85	41.85
6	31-LK - LEVELING KIT FOR USE ON 11/21/31 SERIES SHELIVING MEDIA TECH Tag For LEVELING	19	6.75	128.25
7	ND-75DL-MOB - Nomad Desk, TRX Top Left, 24"D x 75"W x 29"/35"H, Mobile - 809 Silver 29"H HPL worksurface with grommet, Left Hand 6"H Transaction <small>TITLE OF PRODUCT TRANSFERS UPON RECEIPT BY CUSTOMER.</small>	1	3,823.20	3,823.20

yourNBS.com

Remit Payments to: NBS, 6973 Reliable Parkway, Chicago, IL 60686

Description	Quantity	Unit Price	Extended Price
7 3mm PVC Edge, (5) locking casters. A: HPL Main (large) Front: WA Nori 13091-60 B: HPL Front Accent (small) Panel: Formica Greyed Oak 5791-PG C: HPL End Panel: Formica Greyed Oak 5791-PG D: HPL Work Surface & Trans Top: Nevamar White Fiesta MW550-SD D: PVC Work Surface & Trans Top: Silver Gray C600244 E: Powder Coat: 809 Silver MEDIA TECH Tag For CIRCULATION DESK CD-1			
8 MCD-1817 - STEEL CENTER DRAWER 18"W X 17"D X 2"H FINISH: BLACK MEDIA TECH Tag For CIRCULATION DESK CD-1B	1	192.60	192.60
9 WMPS661220-W-LL-P2A - Mobile Pedestal, 2 Box, 1 File Drawers 14-13/16"W x 20-3/4"D x 27"H HPL: Formica Greyed Oak 5791-60 PVC: Silver Gray C600244 Pulls: P2 Nickel LOCK FINISH: Nickel MEDIA TECH Tag For CIRCULATION DESK CD-3	1	509.85	509.85
10 ND-40BR-MOB - Nomad Book Return 30"Dx40"Wx29"H, Mobile HPL/3mm PVC top with radiused corners, book return slot in top, Curved face, steel end frames with floating HPL panel, 4 locking casters. For use with MCD-DBTL1824-24 Depressible Book Truck (not included). Powder coat 809 Silver. B: HPL Front Panel: Formica Greyed Oak 5791-PG C: HPL End Panel: Formica Greyed Oak 5791-PG D: HPL Work Surface: Nevamar White Fiesta MW550-SD	1	1,759.05	1,759.05

TITLE OF PRODUCT TRANSFERS UPON RECEIPT BY CUSTOMER.

ACCEPTED BY _____ TITLE _____ DATE _____

yourNBS.com

Remit Payments to: NBS, 6973 Reliable Parkway, Chicago, IL 60686

Description	Quantity	Unit Price	Extended Price
10 D: PVC Work Surface: Silver Gray C600244 E: Powder Coat: 809 Silver MEDIA TECH Tag For CIRCULATION DESK CD-2			
11 MCD-DBTL-1824-24 - Depressible Platform Book Truck, 18"Dx24.25"Wx24"H HPL construction with 3mm PVC edge banding, spring-loaded platform lift mechanism. HPL: Formica Greyed Oak 5791-PG PVC Edge: Silver Grey C600244 MEDIA TECH Tag For CIRCULATION DESK BKTK	1	1,327.50	1,327.50
12 LOT - MEDIA TECH NON-STANDARD TFL UPCHARGE MEDIA TECH	1	1,574.10	1,574.10
13 LOT - MEDIA TECH PREMIUM LAMINATE UPCHARGE MEDIA TECH	1	1,070.55	1,070.55
14 2024 UPCHARGE - 2024 PRICE INCREASE UPCHARGE MEDIA TECH	1	2,806.20	2,806.20
15 LOT - NON UNION STRAIGHT TIME LABOR TO RECEIVE, DELIVER AND INSTALL NEW PRODUCT PER PRINT ALL WORK TO BE DONE AT ONE TIME INCLUDES BOLTING THE BOOKCASES TO THE WALLS SITE TO BE SEMI-TRUCK ACCESSIBLE PRICING DOES NOT INCLUDE THE REMOVAL OR RELOCATION OF EXISTING PRODUCT ROSE MOVIN	1	9,348.00	9,348.00

Quotation Totals

Sub Total	69,054.45
MEDIA TECH FREIGHT	1,400.00
Grand Total	70,454.45

End of Quotation

TITLE OF PRODUCT TRANSFERS UPON RECEIPT BY CUSTOMER.

ACCEPTED BY _____ TITLE _____ DATE _____



2595 Bellingham • Troy, MI 48083 • 248.823.5400 • 248.823.5401 Fax
2211 Old Earhart Rd. Ste.190 • Ann Arbor, MI 48105 • 248.823.5400 • 248.823.5401 Fax
3201 Pine Tree Rd. Ste. A • Lansing, MI 48911 • 517.886.0072 • 248.823.5401 Fax
5160 Alliance Dr. • Bay City, MI 48706 • 989.895.8574 • 989.895.8545 Fax
4 North St. Clair St. • Toledo, OH 43604 • 419.662.2040 • 248.823.5401 Fax

Quotation 369640

Quote Date 11/30/23

Customer Order

Project 231578

Customer L00002

Terms NET 10 DAYS

Expiration Date

Account Representative MONIQUE DUGAN

yourNBS.com

Remit Payments to: NBS, 6973 Reliable Parkway, Chicago, IL 60686

Quote To

Livonia Public Schools
15125 FARMINGTON RD
LIVONIA, MI, 48154-5413

Ship To

HARRY LAU
Hoover Elementary
15900 Levan Rd
Media Center - Media Tech Product
LIVONIA, MI, 48154-5413

Phone +1 (313) 523-9156

Fax +1 (734) 421-4870

Phone +1 (734) 744-2537

Cell +1 (734) 812-8597

hlau@livoniapublicschools.org

Sales Location Troy

This quote is valid for 30 days from date of quote.

The following contracts have been utilized for pricing on this quote:

NCPA contract

PO required to place order. Please reference NBS quote number on your PO.

Quote includes non-union straight time labor for NBS to receive, deliver and install; any owner requested changes requiring additional delivery trip(s) will result in additional charges to be quoted separately.

Receipt of PO indicates owner approval of product as specified; upon release of order, no changes, cancellations or returns can be made.

If there are project delays and product needs to be held past 30 days in the warehouse additional charges may be incurred by LPS

Media Tech product only

Balance of product needed to be quoted separately

PO needed by April 2024 to meet your target install date of August 2024

Description	Quantity	Unit Price	Extended Price
1 H11-4824-MOB - BENCHMARK SHELVING, DBL FACE STARTER, MOBILE, TFL BACK, HPL PANEL & SHELVES 37"W X 24"D X 48"H HPL construction/3mm PVC edges, TFL back, 2 bases and 4 adjustable shelves, (4) casters HPL: FORMICA GREYED OAK 5791-PG PVC: SILVER GRAY C600244 TFL BACK: GREYED OAK 5791 MEDIA TECH	44	926.10	40,748.40

TITLE OF PRODUCT TRANSFERS UPON RECEIPT BY CUSTOMER.

ACCEPTED BY _____ TITLE _____ DATE _____

yourNBS.com

Remit Payments to: NBS, 6973 Reliable Parkway, Chicago, IL 60686

Description		Quantity	Unit Price	Extended Price
1	Tag For BCM-1			
2	DISP-4724 - Display End Panel, 3 opening, 23-3/4"W x 4"D x 47-3/8"H for use on V21-4824. HPL and 3mm PVC construction HPL: Formica Greyed Oak 5791-PG Interior Back HPL: Pionite Surfin USA SV713SD PVC: Silver Gray C600244 MEDIA TECH Tag For DISPLAY	12	706.05	8,472.60
3	H11-6012 - Benchmark, HPL Shelving Single Faced Starter 37"W x12"D x 60"H HPL construction/3mm PVC edges, TFL back, 1 base and 3 adjustable shelves. HPL: FORMICA GREYED OAK 5791-PG PVC: SILVER GRAY C600244 TFL BACK: GREYED OAK 5791 MEDIA TECH Tag For BC-1S	2	528.30	1,056.60
4	H11-6012A - Benchmark, HPL Shelving Single Faced Adder 36"W x12"D x 60"H HPL construction/3mm PVC edges, TFL back, 1 base and 3 adjustable shelves. HPL: FORMICA GREYED OAK 5791-PG PVC: SILVER GRAY C600244 TFL BACK: GREYED OAK 5791 MEDIA TECH Tag For BC-1A	16	436.95	6,991.20
6	31-LK - LEVELING KIT FOR USE ON 11/21/31 SERIES SHELIVING MEDIA TECH Tag For LEVELING	20	6.75	135.00
7	ND-75DXL-MOB - Nomad Mobile Desk with no transaction 24"Dx75"Wx29"H Mobile 29"H worksurface with grommet no Transaction top, 3mm PVC Edge, (5) locking casters. Left hand front A: HPL Main (large) Front: WA Moroccan 13094-60 B: HPL Front Accent (small) Panel: Formica Greyed Oak 5791-PG C: HPL End Panel: Formica Greyed Oak 5791-PG	1	3,636.45	3,636.45

TITLE OF PRODUCT TRANSFERS UPON RECEIPT BY CUSTOMER.

ACCEPTED BY _____ TITLE _____ DATE _____



yourNBS.com

Remit Payments to: NBS, 6973 Reliable Parkway, Chicago, IL 60686

Description	Quantity	Unit Price	Extended Price
7 D: HPL Work Surface & Trans Top: Nevamar White Fiesta MW550-SD D: PVC Work Surface & Trans Top: Silver Gray C600244 E: Powder Coat: 809 Silver MEDIA TECH Tag For CIRCULATION DESK CD-1			
8 MCD-1817 - STEEL CENTER DRAWER 18"W X 17"D X 2"H FINISH: BLACK MEDIA TECH Tag For CIRCULATION DESK CD-1B	1	192.60	192.60
9 WMPS661220-W-LL-P2A - Mobile Pedestal, 2 Box, 1 File Drawers 14-13/16"W x 20-3/4"D x 27"H HPL: Formica Greyed Oak 5791-60 PVC: Silver Gray C600244 Pulls: P2 Nickel LOCK FINISH: Nickel MEDIA TECH Tag For CIRCULATION DESK CD-3	1	509.85	509.85
10 ND-40BR-MOB - Nomad Book Return 30"Dx40"Wx29"H, Mobile HPL/3mm PVC top with radiused corners, book return slot in top, Curved face, steel end frames with floating HPL panel, 4 locking casters. For use with MCD-DBTL1824-24 Depressible Book Truck (not included). Powder coat 809 Silver. B: HPL Front Panel: Formica Greyed Oak 5791-PG C: HPL End Panel: Formica Greyed Oak 5791-PG D: HPL Work Surface: Nevamar White Fiesta MW550-SD D: PVC Work Surface: Silver Gray C600244 E: Powder Coat: 809 Silver MEDIA TECH Tag For CIRCULATION DESK CD-2	1	1,759.05	1,759.05

TITLE OF PRODUCT TRANSFERS UPON RECEIPT BY CUSTOMER.

ACCEPTED BY _____ TITLE _____ DATE _____

yourNBS.com

Remit Payments to: NBS, 6973 Reliable Parkway, Chicago, IL 60686

Description	Quantity	Unit Price	Extended Price
11 MCD-DBTL-1824-24 - Depressible Platform Book Truck, 18"Dx24.25"Wx24"H HPL construction with 3mm PVC edge banding, spring-loaded platform lift mechanism. HPL: Formica Greyed Oak 5791-PG PVC Edge: Silver Grey C600244 MEDIA TECH Tag For CIRCULATION DESK BKTK	1	1,327.50	1,327.50
12 LOT - MEDIA TECH NON-STANDARD TFL UPCHARGE MEDIA TECH	1	1,841.40	1,841.40
13 LOT - MEDIA TECH PREMIUM LAMINATE UPCHARGE MEDIA TECH	1	1,283.40	1,283.40
14 2024 UPCHARGE - 2024 PRICE INCREASE UPCHARGE MEDIA TECH	1	3,362.40	3,362.40
15 LOT - NON UNION STRAIGHT TIME LABOR TO RECEIVE, DELIVER AND INSTALL NEW PRODUCT PER PRINT ALL WORK TO BE DONE AT ONE TIME INCLUDES BOLTING THE BOOKCASES TO THE WALLS SITE TO BE SEMI-TRUCK ACCESSIBLE PRICING DOES NOT INCLUDE THE REMOVAL OR RELOCATION OF EXISTING PRODUCT ROSE MOVIN	1	10,701.00	10,701.00

Quotation Totals

Sub Total	82,017.45
MEDIA TECH FREIGHT	1,400.00
Grand Total	83,417.45

End of Quotation

TITLE OF PRODUCT TRANSFERS UPON RECEIPT BY CUSTOMER.

ACCEPTED BY _____ TITLE _____ DATE _____



2595 Bellingham • Troy, MI 48083 • 248.823.5400 • 248.823.5401 Fax
2211 Old Earhart Rd. Ste.190 • Ann Arbor, MI 48105 • 248.823.5400 • 248.823.5401 Fax
3201 Pine Tree Rd. Ste. A • Lansing, MI 48911 • 517.886.0072 • 248.823.5401 Fax
5160 Alliance Dr. • Bay City, MI 48706 • 989.895.8574 • 989.895.8545 Fax
4 North St. Clair St. • Toledo, OH 43604 • 419.662.2040 • 248.823.5401 Fax

Quotation 369671

Quote Date 11/30/23

Customer Order

Project 231580

Customer L00002

Terms NET 10 DAYS

Expiration Date

Account Representative MONIQUE DUGAN

yourNBS.com

Remit Payments to: NBS, 6973 Reliable Parkway, Chicago, IL 60686

Quote To

Livonia Public Schools
15125 FARMINGTON RD
LIVONIA, MI, 48154-5413

Ship To

HARRY LAU
Roosevelt Elementary
30200 LYNDON
MEDIA CENTER - MEDIA TECH PRODUCT
LIVONIA, MI, 48154-5413

Phone +1 (313) 523-9156

Fax +1 (734) 421-4870

Phone +1 (734) 744-2537

Cell +1 (734) 812-8597

hlau@livoniapublicschools.org

Sales Location Troy

This quote is valid for 30 days from date of quote.

The following contracts have been utilized for pricing on this quote:

NCPA contract

PO required to place order. Please reference NBS quote number on your PO.

Quote includes non-union straight time labor for NBS to receive, deliver and install; any owner requested changes requiring additional delivery trip(s) will result in additional charges to be quoted separately.

Receipt of PO indicates owner approval of product as specified; upon release of order, no changes, cancellations or returns can be made.

If there are project delays and product needs to be held past 30 days in the warehouse additional charges may be incurred by LPS

Media Tech product only

Balance of product needed to be quoted separately

PO needed by April 2024 to meet your target install date of August 2024

Description	Quantity	Unit Price	Extended Price
1 H11-4824-MOB - BENCHMARK SHELVING, DBL FACE STARTER, MOBILE, TFL BACK, HPL PANEL & SHELVES 37"W X 24"D X 48"H HPL construction/3mm PVC edges, TFL back, 2 bases and 4 adjustable shelves, (4) casters HPL: FORMICA GREYED OAK 5791-PG PVC: SILVER GRAY C600244 TFL BACK: GREYED OAK 5791 MEDIA TECH	31	926.10	28,709.10

TITLE OF PRODUCT TRANSFERS UPON RECEIPT BY CUSTOMER.

ACCEPTED BY _____ TITLE _____ DATE _____

yourNBS.com

Remit Payments to: NBS, 6973 Reliable Parkway, Chicago, IL 60686

Description		Quantity	Unit Price	Extended Price
1	Tag For BCM-1			
2	DISP-4724 - Display End Panel, 3 opening, 23-3/4"W x 4"D x 47-3/8"H for use on V21-4824. HPL and 3mm PVC construction HPL: Formica Greyed Oak 5791-PG Interior Back HPL: WA Catalina 13092.60 PVC: Silver Gray C600244 MEDIA TECH Tag For DISPLAY	5	706.05	3,530.25
3	H11-6012 - Benchmark, HPL Shelving Single Faced Starter 37"W x12"D x 60"H HPL construction/3mm PVC edges, TFL back, 1 base and 3 adjustable shelves. HPL: FORMICA GREYED OAK 5791-PG PVC: SILVER GRAY C600244 TFL BACK: GREYED OAK 5791 MEDIA TECH Tag For BC-1S	2	528.30	1,056.60
4	H11-6012A - Benchmark, HPL Shelving Single Faced Adder 36"W x12"D x 60"H HPL construction/3mm PVC edges, TFL back, 1 base and 3 adjustable shelves. HPL: FORMICA GREYED OAK 5791-PG PVC: SILVER GRAY C600244 TFL BACK: GREYED OAK 5791 MEDIA TECH Tag For BC-1A	3	436.95	1,310.85
5	31-LK - LEVELING KIT FOR USE ON 11/21/31 SERIES SHELIVING MEDIA TECH Tag For LEVELING	7	6.75	47.25
6	ND-75DXL-MOB - Nomad Mobile Desk with no transaction 24"Dx75"Wx29"H Mobile 29"H worksurface with grommet no Transaction top, 3mm PVC Edge, (5) locking casters. Left hand front A: HPL Main (large) Front: Wilsonart Catalina 13092-60 B: HPL Front Accent (small) Panel: Formica Greyed Oak 5791-PG C: HPL End Panel: Formica Greyed Oak 5791-PG	1	3,636.45	3,636.45

TITLE OF PRODUCT TRANSFERS UPON RECEIPT BY CUSTOMER.

ACCEPTED BY _____ TITLE _____ DATE _____



yourNBS.com

Remit Payments to: NBS, 6973 Reliable Parkway, Chicago, IL 60686

Description	Quantity	Unit Price	Extended Price
6 D: HPL Work Surface & Trans Top: Nevamar White Fiesta MW550-SD D: PVC Work Surface & Trans Top: Silver Gray C600244 E: Powder Coat: 809 Silver MEDIA TECH Tag For CIRCULATION DESK CD-1			
7 MCD-1817 - STEEL CENTER DRAWER 18"W X 17"D X 2"H FINISH: BLACK MEDIA TECH Tag For CIRCULATION DESK CD-1B	1	192.60	192.60
8 WMPS661220-W-LL-P2A - Mobile Pedestal, 2 Box, 1 File Drawers 14-13/16"W x 20-3/4"D x 27"H HPL: Formica Greyed Oak 5791-60 PVC: Silver Gray C600244 Pulls: P2 Nickel LOCK FINISH: Nickel MEDIA TECH Tag For CIRCULATION DESK CD-3	1	509.85	509.85
9 ND-40BR-MOB - Nomad Book Return 30"Dx40"Wx29"H, Mobile HPL/3mm PVC top with radiused corners, book return slot in top, Curved face, steel end frames with floating HPL panel, 4 locking casters. For use with MCD-DBTL1824-24 Depressible Book Truck (not included). Powder coat 809 Silver. B: HPL Front Panel: Formica Greyed Oak 5791-PG C: HPL End Panel: Formica Greyed Oak 5791-PG D: HPL Work Surface: Nevamar White Fiesta MW550-SD D: PVC Work Surface: Silver Gray C600244 E: Powder Coat: 809 Silver MEDIA TECH Tag For CIRCULATION DESK CD-2	1	1,759.05	1,759.05

TITLE OF PRODUCT TRANSFERS UPON RECEIPT BY CUSTOMER.

ACCEPTED BY _____ TITLE _____ DATE _____

yourNBS.com

Remit Payments to: NBS, 6973 Reliable Parkway, Chicago, IL 60686

Description	Quantity	Unit Price	Extended Price
10 MCD-DBTL-1824-24 - Depressible Platform Book Truck, 18"Dx24.25"Wx24"H HPL construction with 3mm PVC edge banding, spring-loaded platform lift mechanism. HPL: Formica Greyed Oak 5791-PG PVC Edge: Silver Grey C600244 MEDIA TECH Tag For CIRCULATION DESK BKTK	1	1,327.50	1,327.50
11 LOT - MEDIA TECH NON-STANDARD TFL UPCHARGE MEDIA TECH	1	1,062.00	1,062.00
12 LOT - MEDIA TECH PREMIUM LAMINATE UPCHARGE MEDIA TECH	1	832.05	832.05
13 2024 UPCHARGE - 2024 PRICE INCREASE UPCHARGE MEDIA TECH	1	2,173.05	2,173.05
14 LOT - NON UNION STRAIGHT TIME LABOR TO RECEIVE, DELIVER AND INSTALL NEW PRODUCT PER PRINT ALL WORK TO BE DONE AT ONE TIME INCLUDES BOLTING THE BOOKCASES TO THE WALLS SITE TO BE SEMI-TRUCK ACCESSIBLE PRICING DOES NOT INCLUDE THE REMOVAL OR RELOCATION OF EXISTING PRODUCT ROSE MOVIN	1	6,416.00	6,416.00

Quotation Totals

Sub Total	52,562.60
MEDIA TECH FREIGHT	1,334.00
Grand Total	53,896.60

End of Quotation

TITLE OF PRODUCT TRANSFERS UPON RECEIPT BY CUSTOMER.

ACCEPTED BY _____ TITLE _____ DATE _____